

V-100  
48" HORIZONTAL SEPARATOR VESSEL  
48" ID x 16'-0" s/s  
MAWP: 1440 PSIG  
-20°F/100°F  
1/8" CORROSION ALLOWANCE  
3 PHASE  
RT-1, PWHT


V-200  
FUEL GAS SEPARATOR  
8" x 36" OAL  
MAWP: 150 PSIG  
-20°F/100°F  
1/8" CORROSION ALLOWANCE  
c/w INTEGRAL HLSD  
SOUR SERVICE


D-210  
FILTER  
MODEL: FLODR1-G25A  
MAWP: 250 PSIG  
c/w (2) TWO 25MS CARTRIDGES

BH-400/401  
NATURAL GAS HEATERS  
MAKE: CATADYNE, MK SERIES  
24" x 24", 12VDC START  
c/w GRILL, VENT HOOD, SAFETY SHUTOFF,  
REG., THERMOSTAT & 30' START UP CABLES


TK-500  
METHANOL TANK  
WESTEEL  
MODEL: GFDW-1000SC  
500 GAL  
DUAL WALL  
SHIPLOOSE w/ 48" STAND

P-510/520  
METHANOL PUMPS  
MAKE: BRUIN  
MODEL: BR5101 LP  
DISCH. PRESSURE: 3000 PSIG  
17 GPD  
1/4" PLUNGER, BUNA PACKING

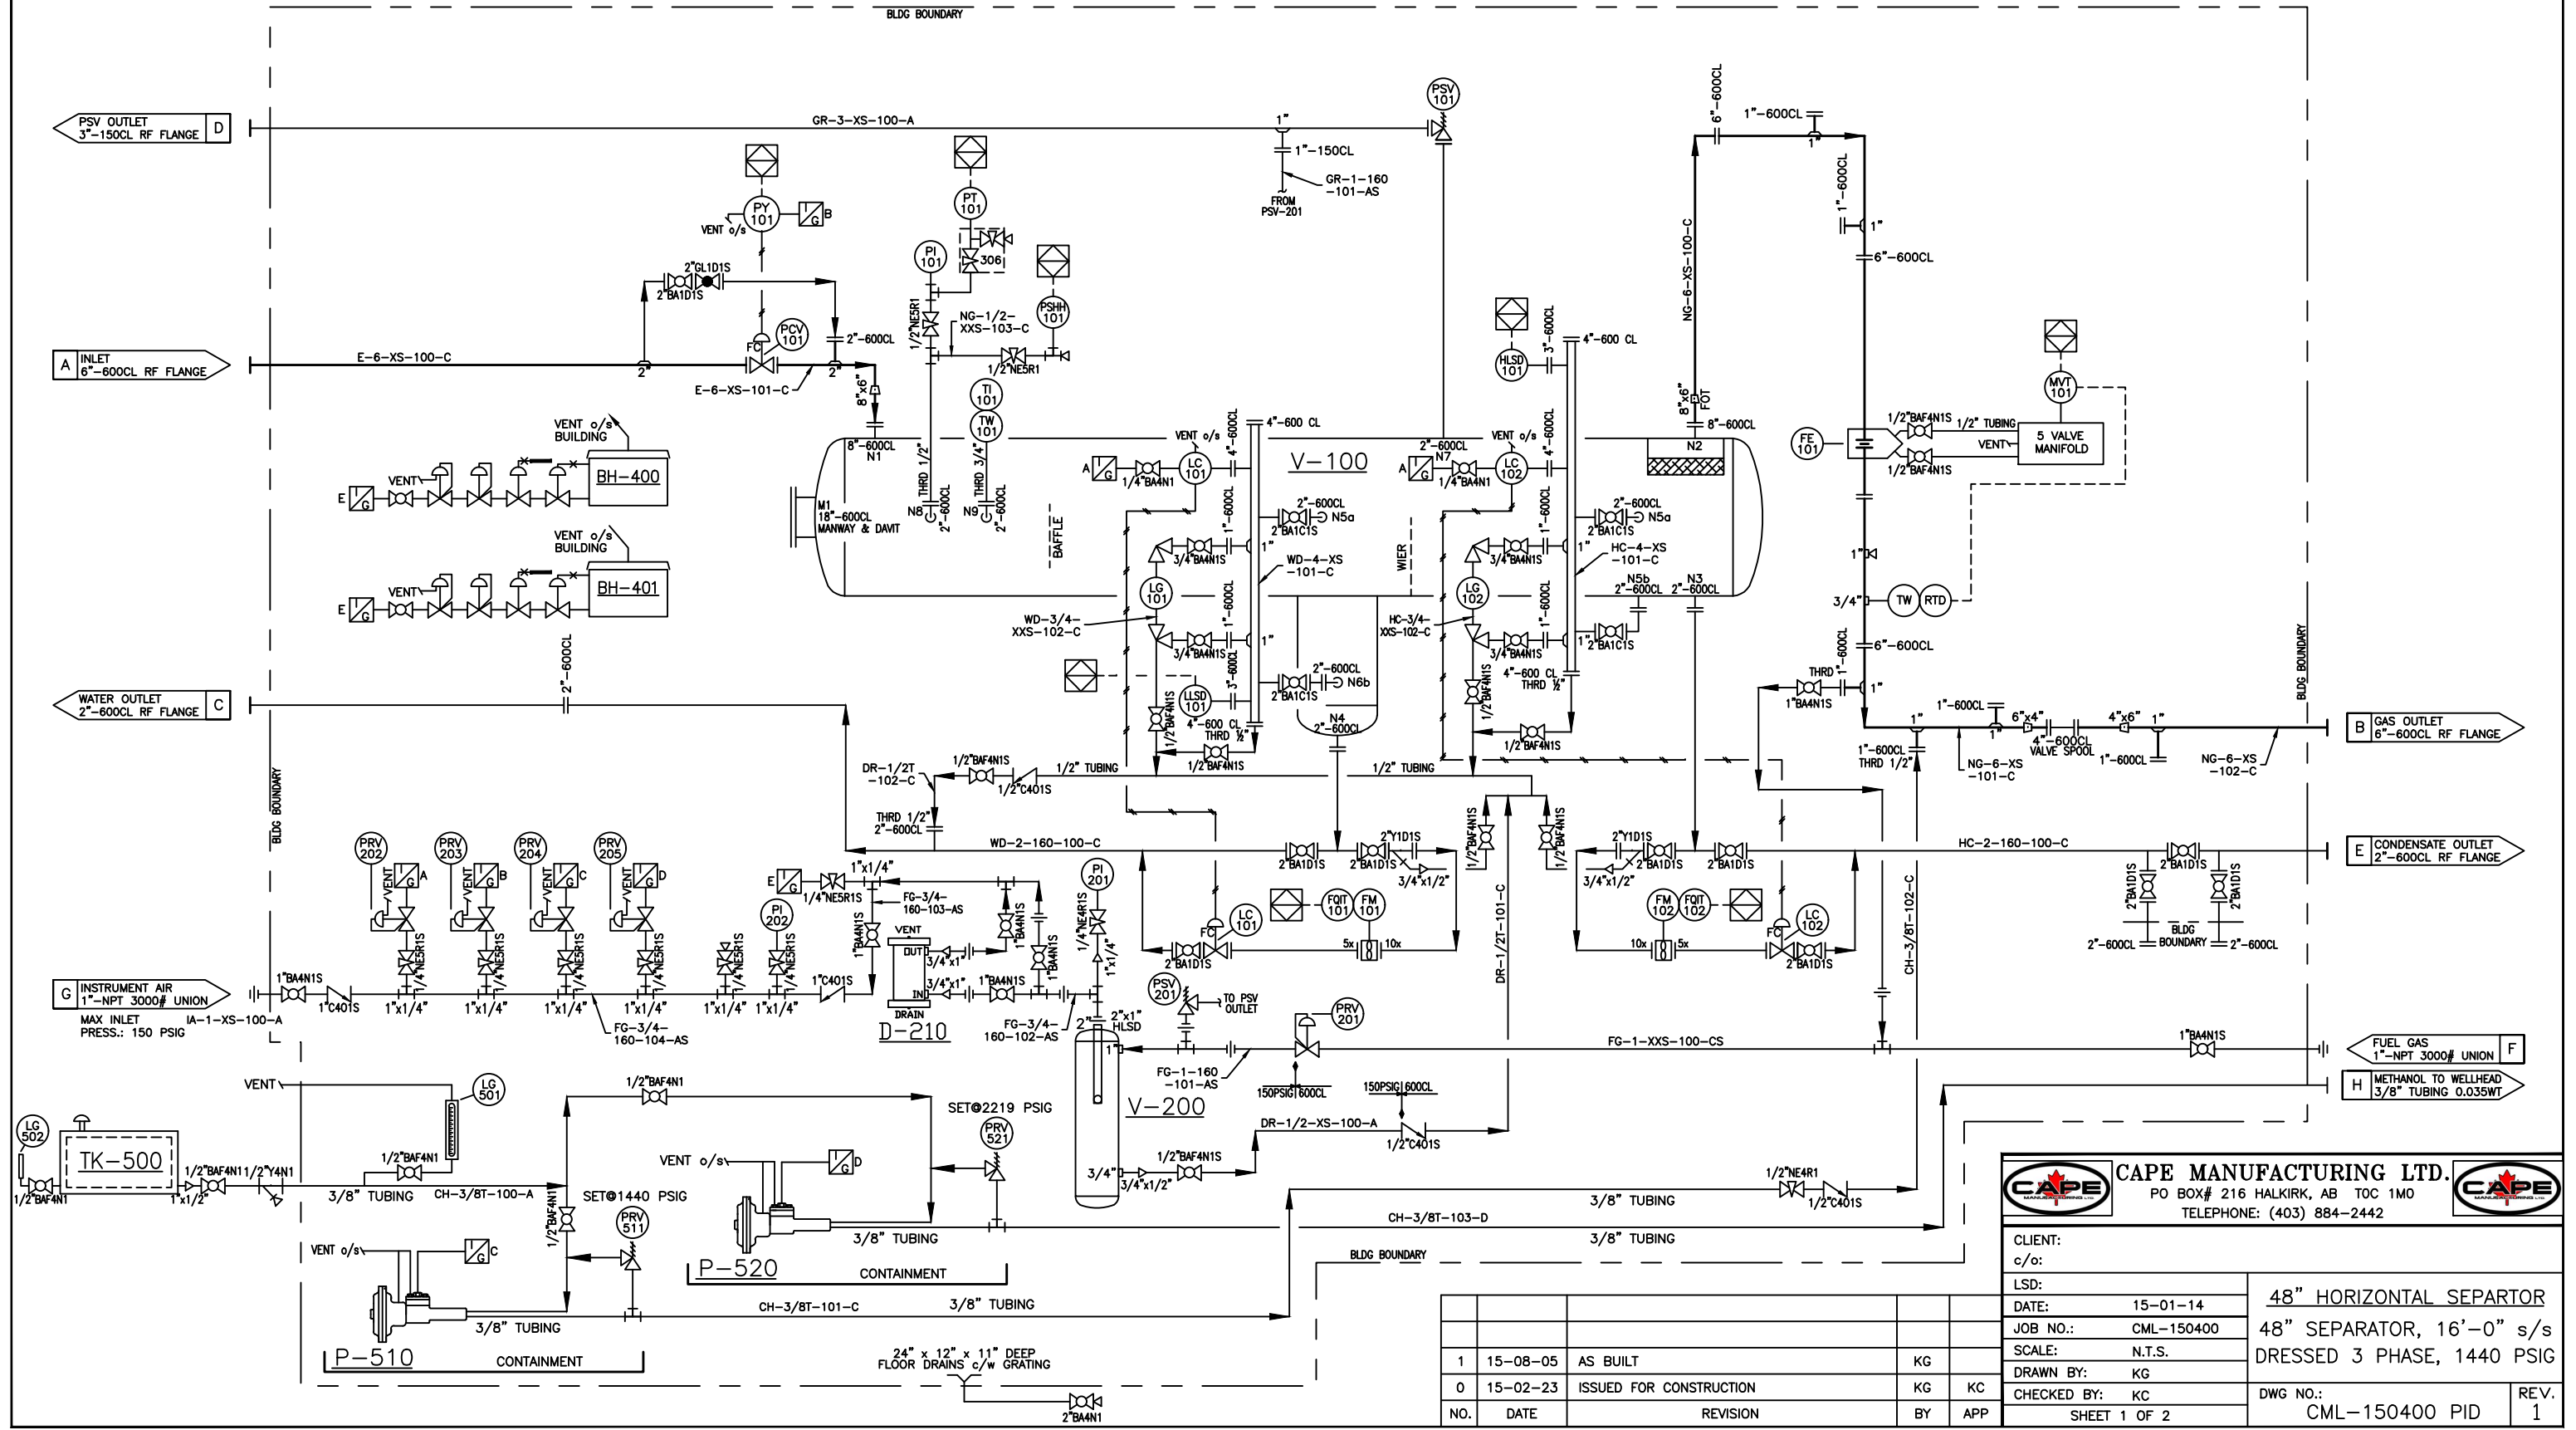



**CAPE MANUFACTURING LTD.**  
PO BOX# 216 HALKIRK, AB T0C 1M0  
TELEPHONE: (403) 884-2442



CLIENT:		48" HORIZONTAL SEPARTOR	
c/o:		48" SEPARATOR, 16'-0" s/s	
LSD:		DRESSED 3 PHASE, 1440 PSIG	
DATE:	15-01-14		
JOB NO.:	CML-150400		
SCALE:	N.T.S.		
DRAWN BY:	KG		
CHECKED BY:	KC		
SHEET 1 OF 2		DWG NO.:	CML-150400 PID
		REV.	1

NO.	DATE	REVISION	BY	APP
1	15-08-05	AS BUILT	KG	
0	15-02-23	ISSUED FOR CONSTRUCTION	KG	KC