



THE CONTENTS OF THIS DRAWING ARE CONFIDENTIAL AND MAY NOT BE REPRODUCED WITHOUT WRITTEN PERMISSION

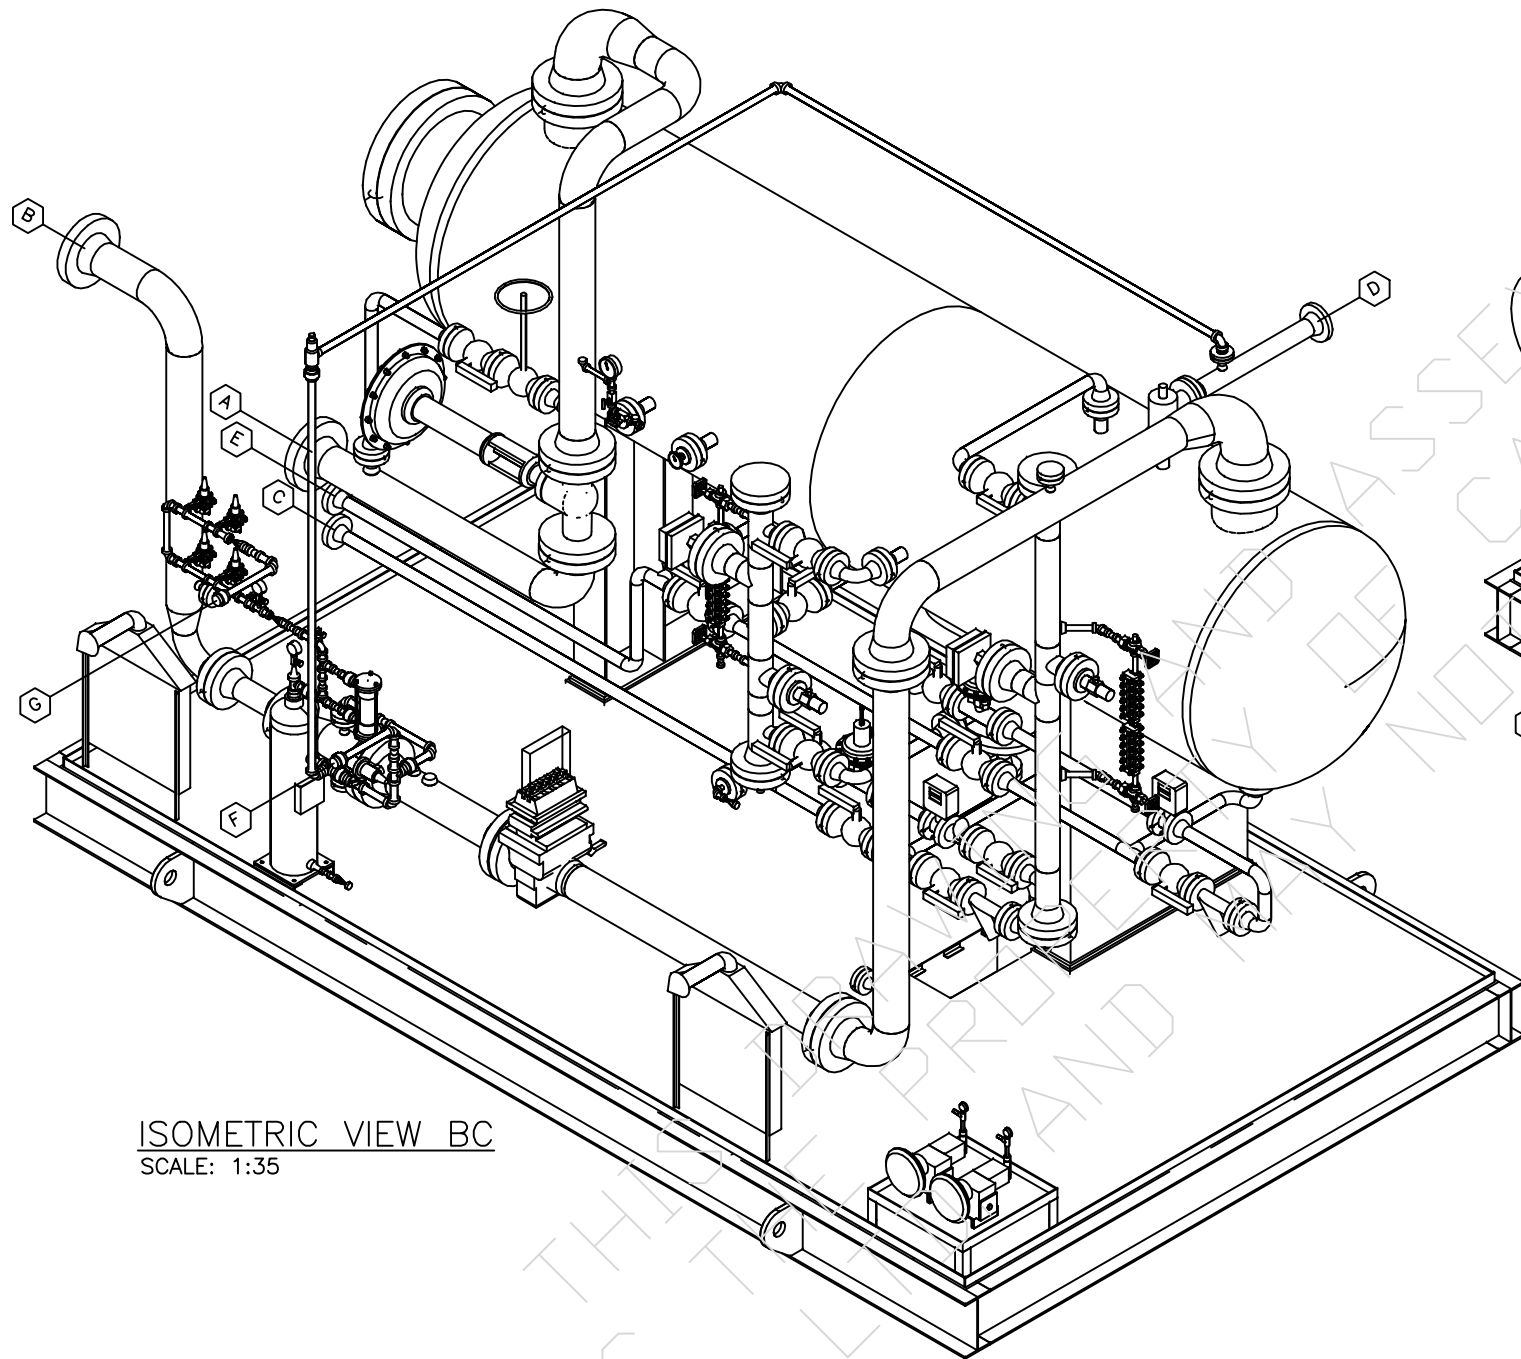

PROPERTY OF CAPE MANUFACTURING LTD.

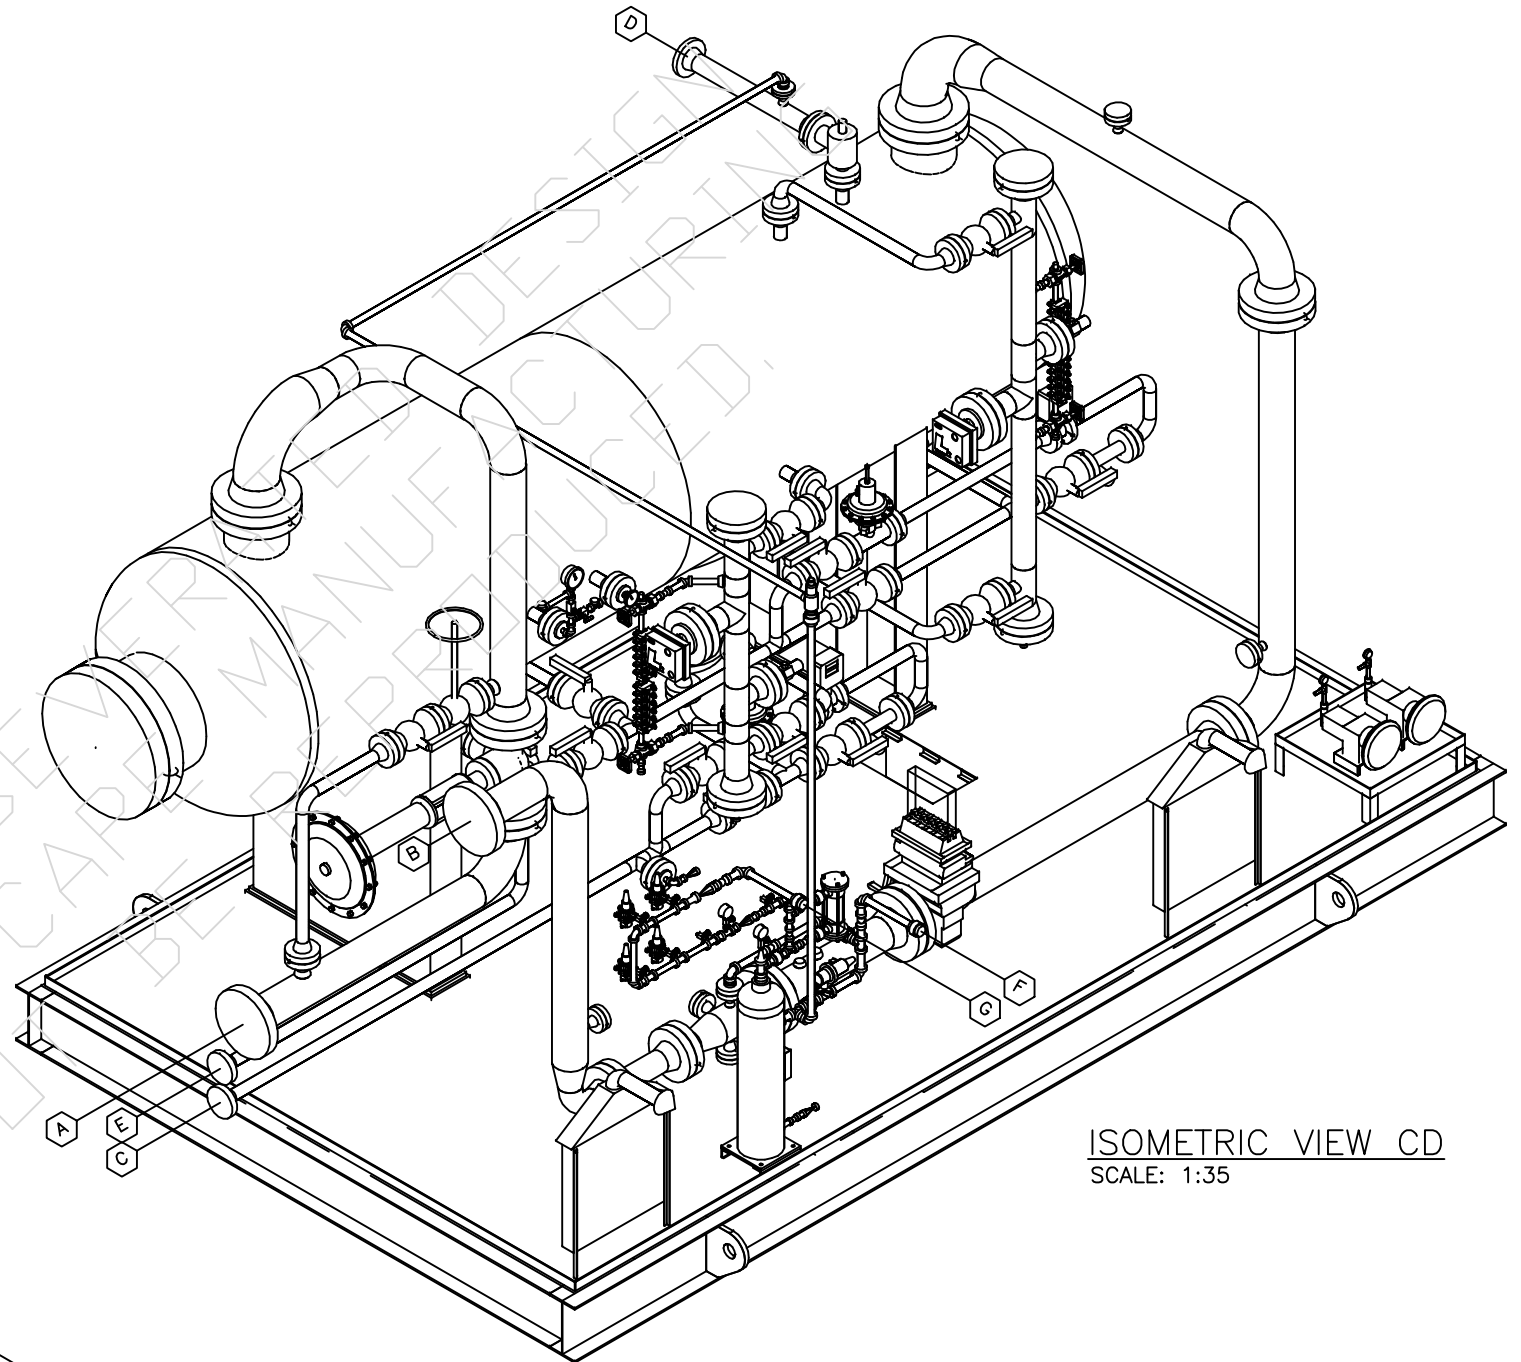

ISOMETRIC VIEW BC
SCALE: 1:35



ISOMETRIC VIEW CD
SCALE: 1:35

| | | | | | |
|--|----------|--------------------------|----------------------------|-----|------|
| | | | | | |
| 1 | 15-08-05 | AS BUILT | KG | | |
| 0 | 15-02-25 | ISSUED FOR CONSTRUCTION | KG | KC | |
| NO. | DATE | REVISION | BY | APP | |
| <div><div></div><div>CAPE MANUFACTURING LTD. PO BOX# 216 HALKIRK, AB T0C 1M0 TELEPHONE: (403) 884-2442</div><div></div></div> | | | | | |
| CLIENT: c/o: | | | | | |
| LSD: | | 48" HORIZONTAL SEPARATOR | | | |
| DATE: | | 15-05-06 | 48" SEPARATOR, 16'-0" s/s | | |
| JOB NO.: | | CML-150400 | DRESSED 3 PHASE, 1440 PSIG | | |
| SCALE: | | SEE DWG | | | |
| DRAWN BY: | | KG | | | |
| CHECKED BY: | | KC | DWG NO.: | | REV. |
| SHEET 3 OF 3 | | | CML-150400 ISO | | 1 |