


## BH-102/103

BUILDING HEATERS (TWO)

SIZE: 6' x 36'  
MAWP: 285 PSIG  
C.A.: 1/8", RT-1, PWHT  
C/W HLSD  
MANUFACTURED IN 2006  
REGISTERED IN AB, BC, SKS

MAKE: CATADYNE  
12,000 BTU/HR C/W 30"OF  
12 VDC START CABLES, VENT HOOD  
GRILL, SAFETY SHUTOFF, REGULATOR, THERMOSTAT  
NATURAL GAS (from process-customer has sweet wells)

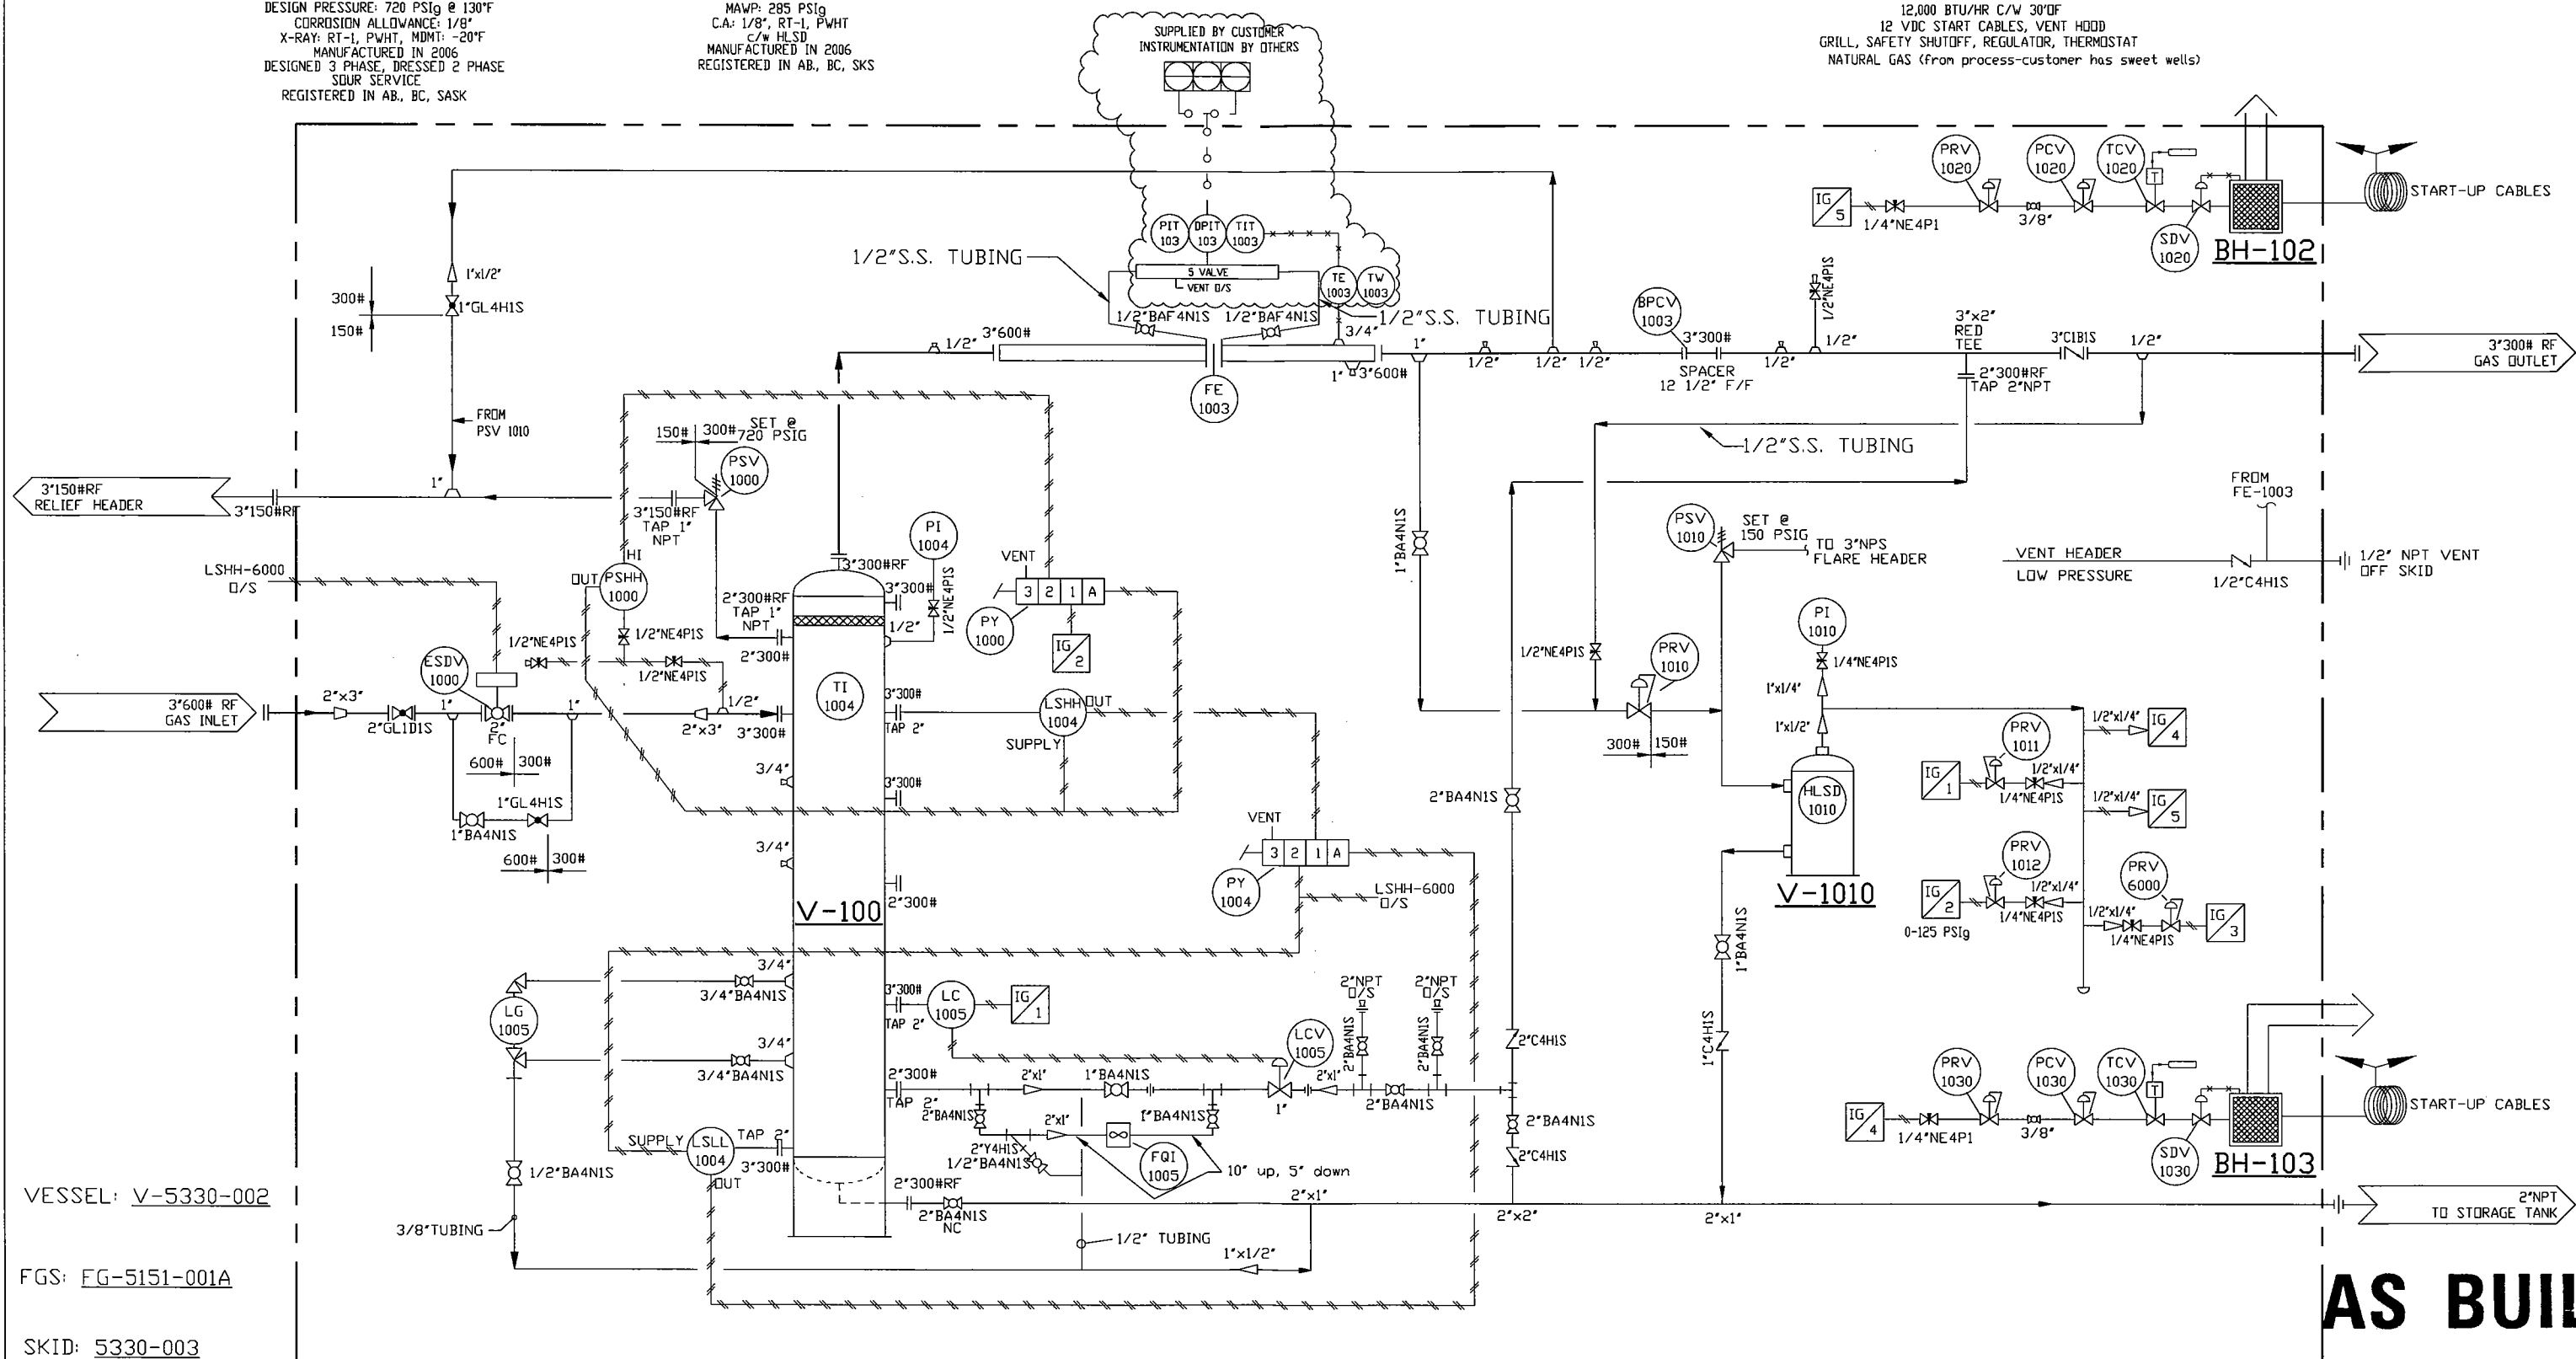

# AS BUILT

2	AS BUILT	CMP	06-07-1
1	REV. HEATER SUPPLY PER CUSTOMER	CP	06-05-2
0	ISSUED FOR CONSTRUCTION	CP	06-05-2
A	ISSUED FOR APPROVAL	CP	06-05-1
NO.	REVISIONS	DWN	APPR DATE



DATE 06-05-15	CLIENT ANADARKO CANADA CORPORATION LSD: ENCHANT		
DESIGNED BY IPS	TITLE 20" OD x 8'-0" S/S 2 PHASE SOUR VERTICAL SEPARATOR PACKAGE DESIGN PRESSURE: 720 PSIG @ 100°F, 1/8" C.A.		
DRAWN BY C. PRICHARD			
CHECKED BY <i>CP</i>			
APPROVED BY	PROJECT NO. 5330-001	FILENAME 5330-001PID	REFERENCE NO.
SCALE N.T.S.	SHEET NO. 1 OF 1	DRAWING NO. CCL-5330-001PID	REV. NO. A