


ISSUED FOR CONSTRUCTION

SIGNED: *[Signature]*

DATE: *Jun 20/12*

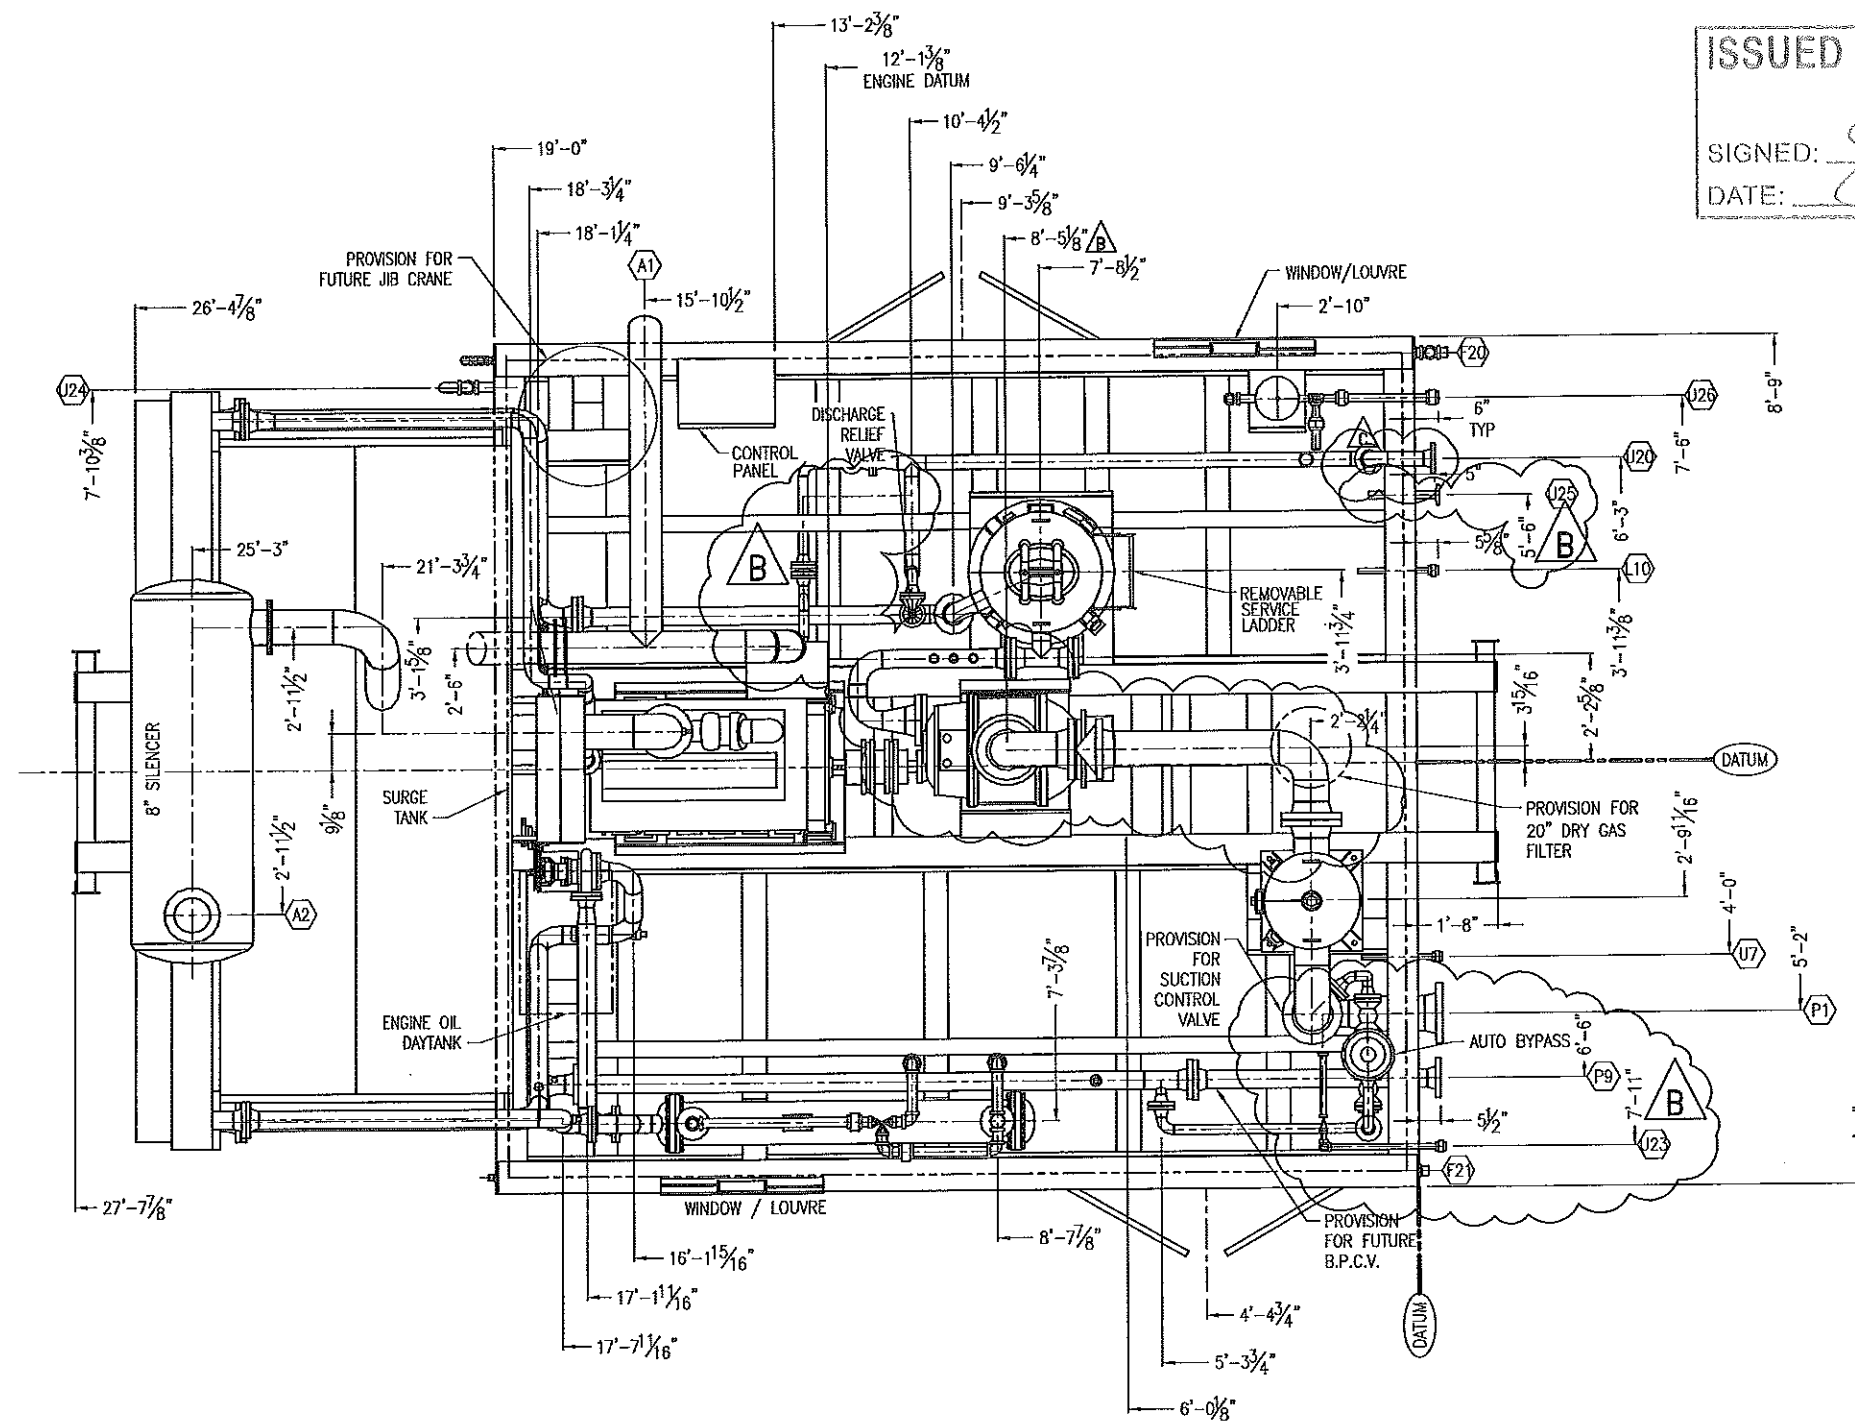

U25	1 1/2\"-150#RF	ENGINE START GAS INLET
U23	1\"-NPT	PURGE CONNECTION
A2	8\"-TUBE	ENGINE EXHAUST
A1	8\"-TUBE	ENGINE AIR INLET
F21	2\"-NPT	LIQUID HOLDING TANK PUMP-OUT
F20	2\"-NPT	WASTE OIL TANK PUMP-OUT
J24	2\" PIPE	ENGINE STARTER OUTLET (NOT USED)
U26	1 1/2\"-NPT	ENGINE FUEL GAS INLET
L10	1\"-NPT	OIL SEPARATOR DRAIN
U7	1\"-NPT	SCRUBBER DRAIN HEADER
U20	3\"-150# RF	FLARE HEADER
P9	4\"-300# RF	DISCHARGE OUTLET
P1	8\"-300# RF	SUCTION INLET
TAG	SIZE & RATING	SERVICE / DESCRIPTION

SCHEDULE OF OPENINGS

TOTAL PACKAGE WEIGHT = APPROX 72,000 lbs
TOTAL PACKAGE LENGTH = APPROX 29'-5"
TOTAL PACKAGE WIDTH (Incl. Eaves) = 18'-4"
TOTAL PACKAGE HEIGHT = 24'-9"

SHIPPING LENGTH = APPROX 29'-5"
SHIPPING WIDTH (Incl. Eaves) = 18'-4"
SHIPPING HEIGHT = 15'-6"

REV	DATE	BY	APPR	DESCRIPTION
C	12-06-20	GW	SZ	REMSD FLARE HEIGHT
B	12-06-06	GW	SZ	LEASED TO PENNWEST
A	07-08-07	BES	LS	AS BUILT
O	07-02-08	BES	LS	ISSUED FOR CONSTRUCTION

REVISIONS

NORTH SHOP 5475 - 56th AVENUE S.E. CALGARY, AB T2C 3X6 PHONE: (403) 203-4545 FAX: (403) 236-4463		BIDELL™ GAS COMPRESSION		SOUTH SHOP 6900 - 112th AVENUE S.E. CALGARY, AB T2C 4Z1 PHONE: (403) 235-5877 FAX: (403) 272-7749	
GENERAL ARRANGEMENT (PLAN)					
WAUKESHA F18GL / SULLAIR PC25L / ACE J96					
CUSTOMER: PENNWEST EXPLORATION					
LOCATION: SWAN HILLS					
LSD:		10-32-067-09 W5M		JOB#:	
DWN		DATE		SCALE	
BES		06-09-27		1/4" = 1'-0"	
DWG#				05-412-100A	
REV				C	