


ALIGNMENT DETAIL

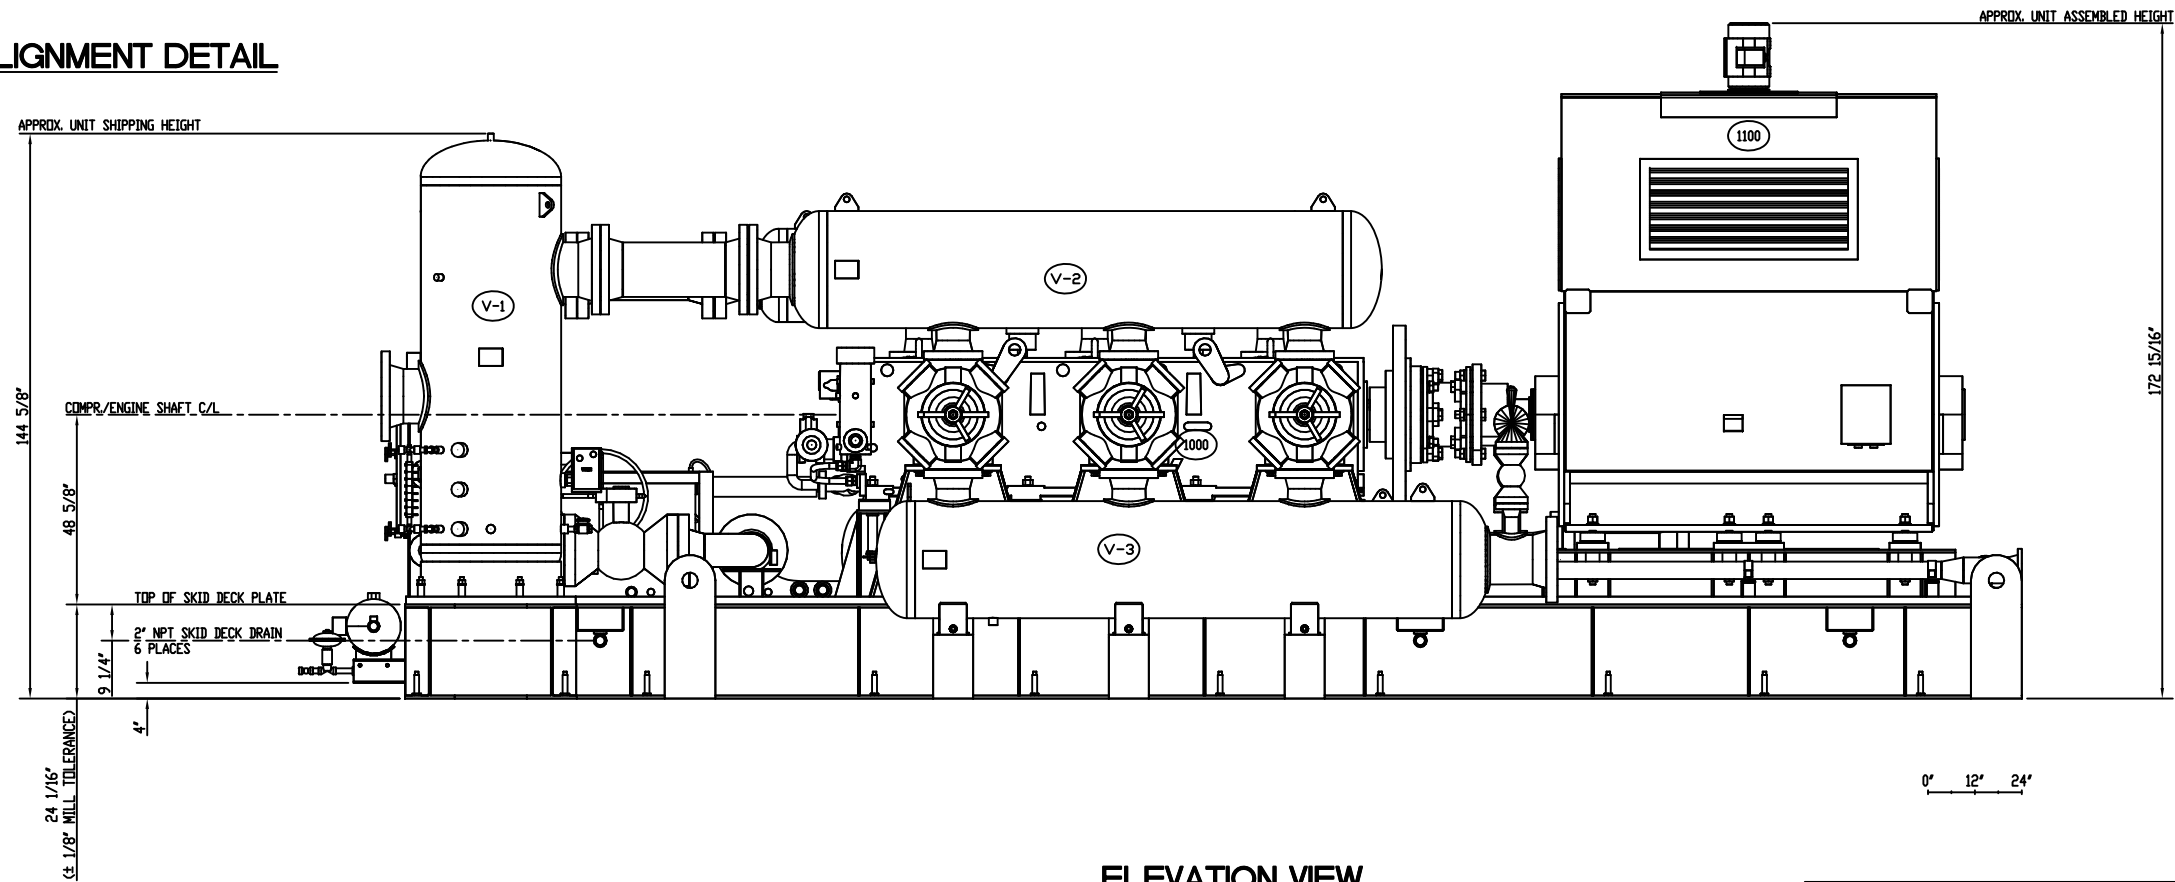

ELEVATION VIEW  
(VIEW "B-B")

NOTICE: THIS DOCUMENT CONTAINS PROPRIETARY INFORMATION AND IT SHALL NOT BE USED OR REPRODUCED OR ITS CONTENTS DISCLOSED, IN WHOLE OR IN PART, WITHOUT THE PRIOR WRITTEN CONSENT OF A G EQUIPMENT CO.

REVISIONS				REVISIONS				DESCRIPTION:			A G EQUIPMENT PROJECT:		
								GENERAL ASSEMBLY ARIEL JGC6 W/ 5000HP MOTOR			11379-381		
NO	DATE	DESCRIPTION	BY	NO	DATE	DESCRIPTION	BY	DRAWN BY		NAME	DATE	SCALE:	
05	05/08/2012	ADDED SCRUBBER 2" NPT SIGN GLASS CONN.	LN	00	02/03/2012	FOR CUSTOMER REVIEW/ PULSATION STUDY	LN	CHECKED BY	JAL	02/03/2012		1/2"=1'-0"	CUSTOMER P.O. NO.:
06	06/12/2012	AS BUILT	LN	01	02/20/2012	PER PULSATION STUDY	LN	PROJECT ENG.	JAL	02/03/2012			210150-DW222
				02	03/02/2012	PER ENGINEER	LN	APPROVED BY					PROJECT: FORT BEELER PLANT REJECTION
				03	04/17/2012	REVISED DRAIN SUMPS AND PUMP	LN	CERTIFIED BY					DRAWING NUMBER: 11379-A1B
				04	05/01/2012	MECHANICAL STUDY/REL. FOR FAB.	LN						ISSUE: 06



BROKEN ARROW, OKLA. 74012 • PHONE 918-250-7386 • FAX 918-250-7393

CUSTOMER: CAIMAN ENERGY, LLC

PROJECT: FORT BEELER PLANT REJECTION

DRAWING NUMBER: 11379-A1B