




## GENERAL ARRANGEMENT

NOZZLE SCHEDULE				
MARK	SERVICE	SIZE	RATING	TYPE
1	FUEL GAS INLET	4"	150#	RF
2	GAS TIGHT VENT	1/2"	—	RP
3	INSTRUMENT AIR INLET	2"	100#	RF
4	FLOOR DRAIN	2"	150#	RF

LENGTH	651 15/16"
WIDTH	420 1/16"
HEIGHT	236"
WEIGHT	148,000 lbs.

SHIPPING DIMENSIONS (Single Piece):	
LENGTH	651 15/16"
WIDTH	194 9/16"
HEIGHT	198"
WEIGHT	74,000 lbs.

CENTER OF GRAVITY:



X FROM REFERENCE POINT: 376" (EA. UNIT)


Y FROM REFERENCE POINT: 96" (EA. UNIT)

Z FROM REFERENCE POINT: 40" (EA. UNIT)


T1 AND DRUM TOP OF RIG	
ENRIDGE CRANE EXISTING	5 TONNES
SEAL PAN	FLAT/SLOPED/NONE
LOADING METHOD	LIVE ROLL/CRANE/JACK & ROLL

ADDRESS


1. ALL (2) DIMENSIONS TAKEN FROM TOP OF SKID.
2. ALL SKID EDGE CONNECTIONS  $\pm 1/4"$  TOLERANCE.
3. ALL TAIL DIMENSIONS FROM REFERENCE POINT. (2)
4. SKID DEPTH: 16"
5. STENCIL NEAR LIFTING POINTS ON OPPOSITE SIDES OF THE SKID BASE, MINIMUM FOUR LOCATIONS AND COLOR RED:  
"VERTICAL LIFTING ONLY"

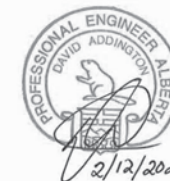

**FINAL  
AS BUILT**

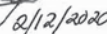NAME T. COLEMAN DATE APR 15/19

### GENERAL ARRANGEMENT

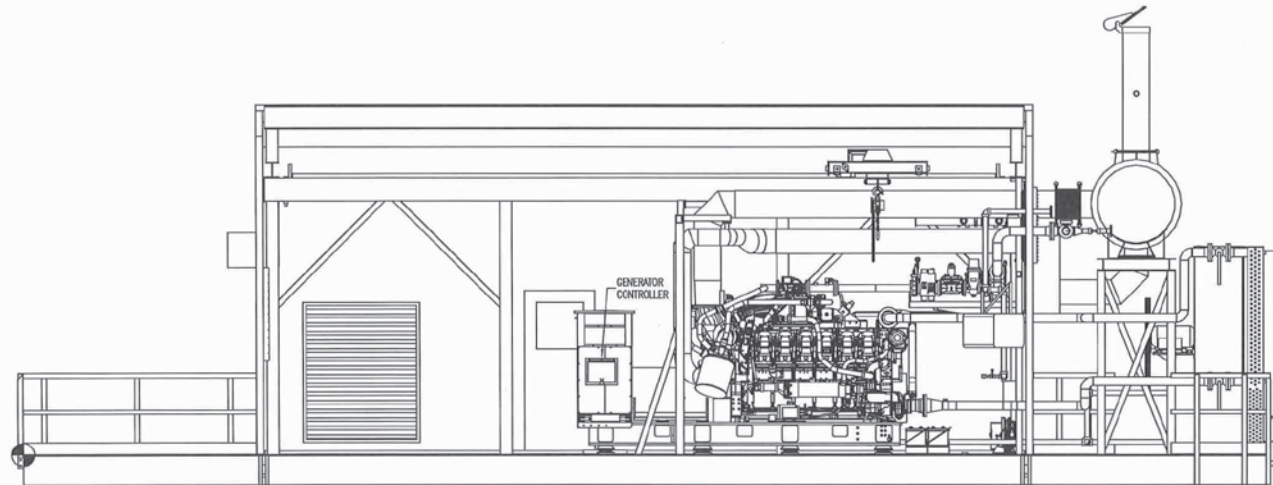


ELEVATION VIEW B




**FINAL AS BUILT**  
DATE: 15/04/2018 BY: APR 15/18

							DATE	MAR 26/18	SCALE	NTS																																																																																																																																																																																																																																																																																																																																																																																																																																																																																																																																																																																																																																																																																																																																																																																																																																																																																																																																																																																																																																																																																																																																																																																																																																																																																																																																																																																																																																																																																																																																																																																																																																																																																																																																																														
--	--	--	--	--	--	--	------	-----------	-------	-----	--	--	
GENERAL ARRANGEMENT

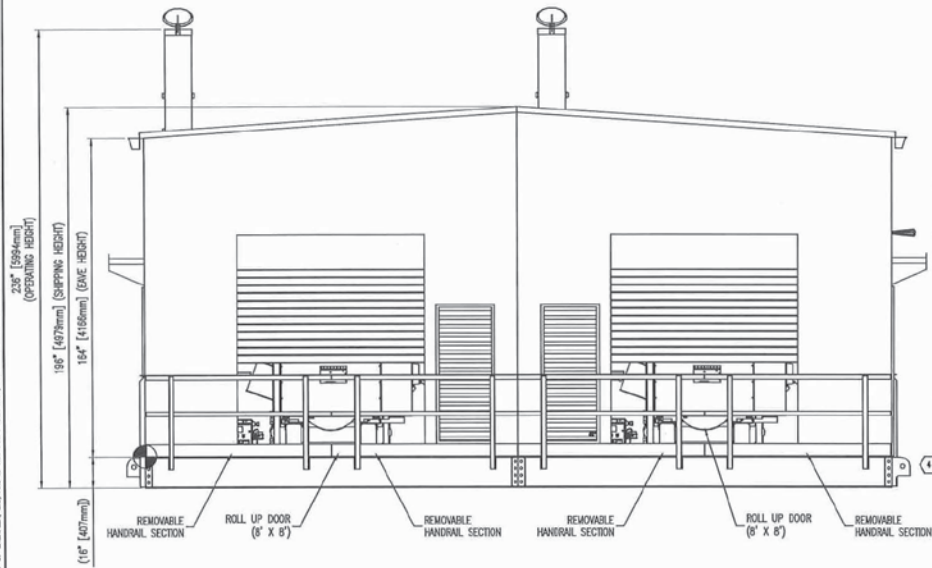

END VIEW C

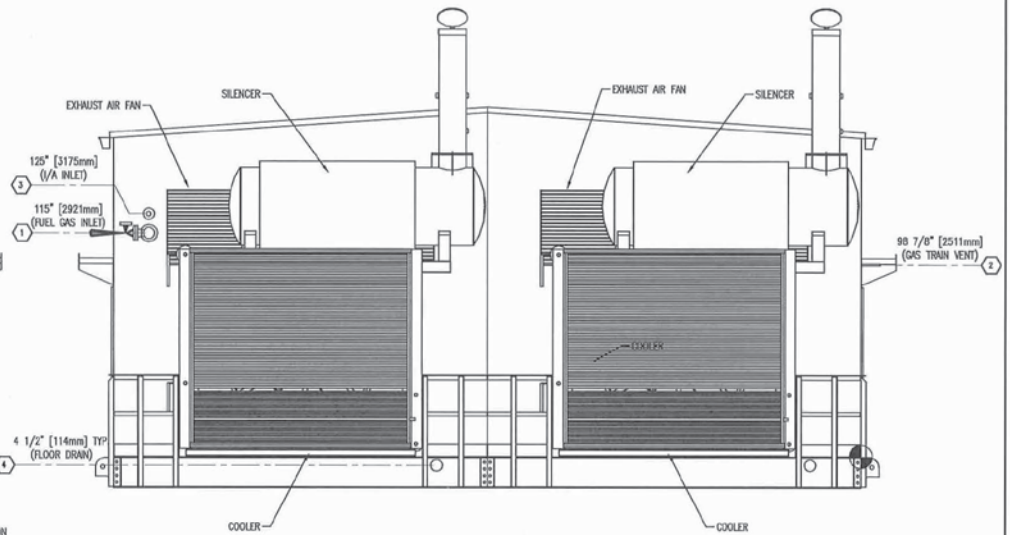

END VIEW D




**FINAL AS BUILT**  
DATE: 10/03/2019 DATE: APR 15/19


				DATE	MAR 26		SCALE	NTS						GENERAL ARRANGEMENT						
				DRAWN BY	T.GOLUBIC		CHECKED BY	D.ADDINGTON												
				PROJECT MANAGER	J.GARCIA		PROJECT ENGINEER	D.ADDINGTON												
				CUST PO	2850052404															
2	AS BUILT			APR 15/19	TBC	DA														
1	ADDED HANDRAIL			AUG 23/18	TBC	DA														
0	ISSUED FOR CONSTRUCTION			JUL 25/18	TBC	DA														
REV	DESCRIPTION			DATE	BY	APR	APR 15/19	TBC	DA	APR 15/19	TBC	DA	DWG NO		E002662-201		SHT	4	REV	2
							APR 15/19	TBC	DA	APR 15/19	TBC	DA	WORK ORDER		E002662-01					
							APR 15/19	TBC	DA	APR 15/19	TBC	DA								
							APR 15/19	TBC	DA	APR 15/19	TBC	DA								
							APR 15/19	TBC	DA	AP										



DATE: Apr 11, 2018, 10:44 AM THE INFORMATION CONTAINED HEREIN IS THE CONFIDENTIAL PROPERTY OF ENERFLEX LTD. AND IS NOT FOR PUBLICATION, AND NO PART THEREOF SHALL BE COPIED OR COMMUNICATED TO A THIRD PARTY WITHOUT AUTHORIZATION FROM ENERFLEX LTD.

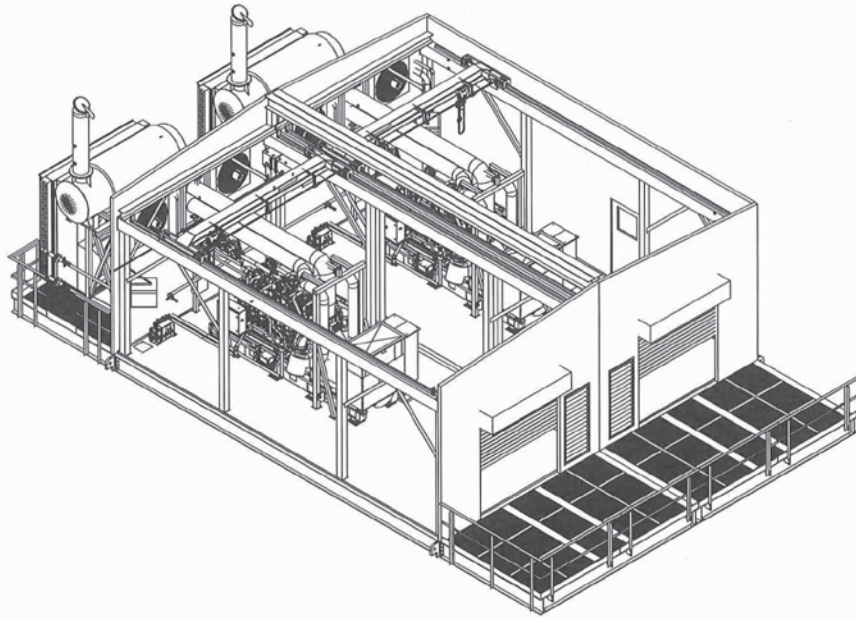

ISOMETRIC VIEW

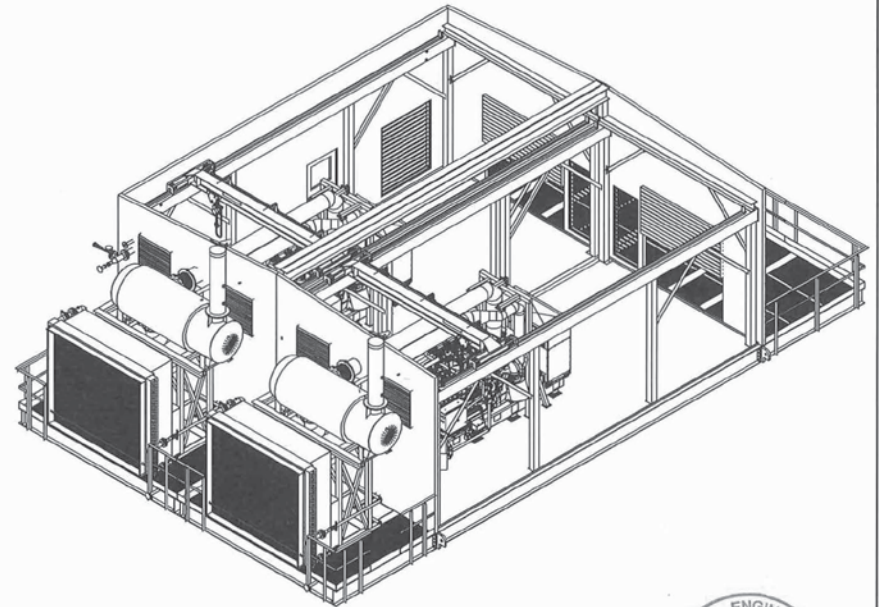

ISOMETRIC VIEW



**FINAL AS BUILT**  
DATE: 10/03/2018 BY: APR 15/19

						DATE MAR 26/18		SCALE NTS		SPRUE NOZZLE EXPANSION CS-2 & CS-N5 PCE10000		<b>ENERFLEX</b> Calgary, Alberta, Canada		GENERAL ARRANGEMENT	
						DRAWN BY T.GOLUBIC		CHECKED BY D.ADDINGTON							
								PROJECT MANAGER J.CHAPKA		PROJECT ENGINEER D.ADDINGTON					
2		AS BUILT		APR 15/18		TBC		DA		CUST PO 2850052404					
1		ADDED HANDRAL		AUG 23/18		TBC		DA							
0		ISSUED FOR CONSTRUCTION		JUL 25/18		TBC		DA							
REV		DESCRIPTION		DATE		BY		APR		APESA PERMIT No: P8651		OPER. CODE 106/206/00/511/001		WORK ORDER EDO02599-01	
												DWG NO E002662-201		SHT 5	
														REV 2	

**ENERFLEX**  
Calgary, Alberta,  
Canada

GENERAL ARRANGEMENT

FILE NAME: P:\\_LSP\_CSP\_General Arrangement\2018-01-01\00000000-01.dwg - Project: 106/206/00/511/001 - Revision: 2 - Date: 04/11/2018