


P-501A/B
HOT OIL CIRCULATION PUMP
FLOW: 75m³/HR @ 235 kPa (EACH)
MODEL: 2K3X2-82RV
MAKE: FLOWSERVE
PM-501A/B
HOT OIL PUMP MOTOR
MAKE: FLOWSERVE DURCO
TYPE: 2K3X2-82RV
RPM: 3550
POWER: 18.7 kW/460 VAC / 3 PH / 60Hz

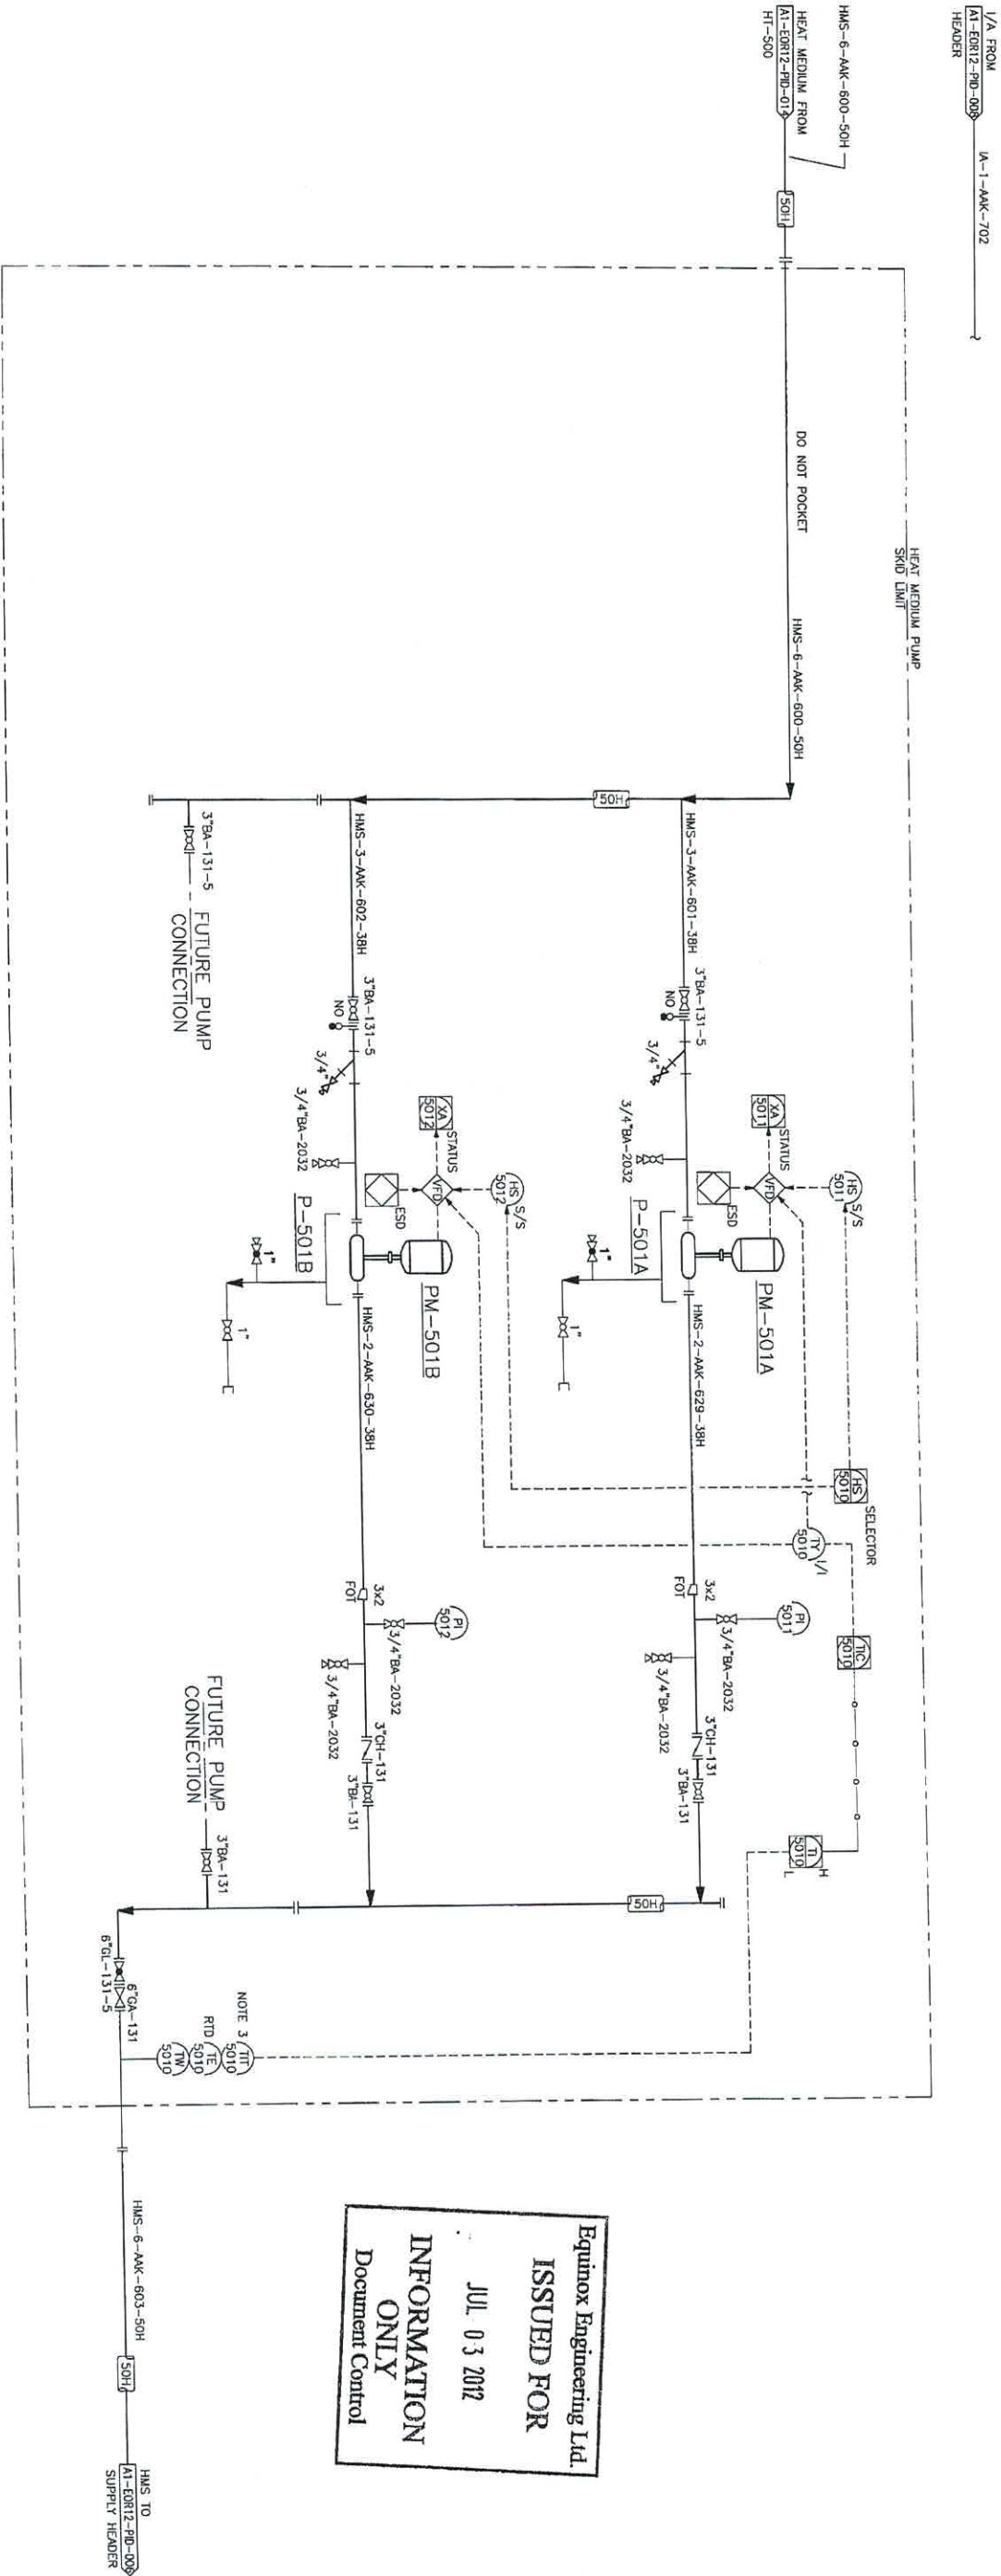

Equinox Engineering Ltd.
ISSUED FOR
JUL 03 2012
INFORMATION
ONLY
Document Control

NOTES				REFERENCE DRAWINGS				DESCRIPTION				ENGINEERING & PERMIT STAMPS			
1. GROUP TEST HEADER SHOWN ON D-04124-MFD-003.				A3-EOR12-ISO-001	REV.	DATE	BY	ISSUED FOR CONSTRUCTION (MRC JOB# 04124)	CHK'D	APP'D	CLIENT	DRAWN:	CA	05.01.05	<div>MILLENNIA Resource Consulting</div> <div>APACHE ZAMA FIELD ACID GAS FLOW BACK PROJECT HEAT MEDIUM PUMPS MECHANICAL FLOW DIAGRAM</div>
2. REFER TO 08625 TIE-IN LIST.					0	05.06.13	HY	AS BUILT (MRC JOB# 04124)				CHECKED:			
3. RE-USE THE EXISTING TIE IN AND RELOCATE.					2	06.05.10	TR	ISSUED FOR INFORMATION (MRC JOB# 05490)				DESIGN:			
					1	06.05.10	KM	AS BUILT (MRC JOB# 05490)				APPROVED:			
					3	07.03.30	KM	CHANGED PUMP AND CONTROL (MRC JOB #08005)				CLIENT:			
					4	08.11.18	DP	ISSUED FOR CONSTRUCTION (MRC JOB #08005)							
					5	09.01.27	FE	RE-NAMED DRIVING NAME & RE-NUM. TIE-IN #5 (MRC JOB #08625)							
					6	09.07.15	CA	REVERSED BLOCK VALVE ADDITION (MRC JOB #08005)							
					7	09.09.15	DP	ISSUED FOR INFORMATION (EEL PROD. #156-00-18)							
					8	12.06.19	SWP								