
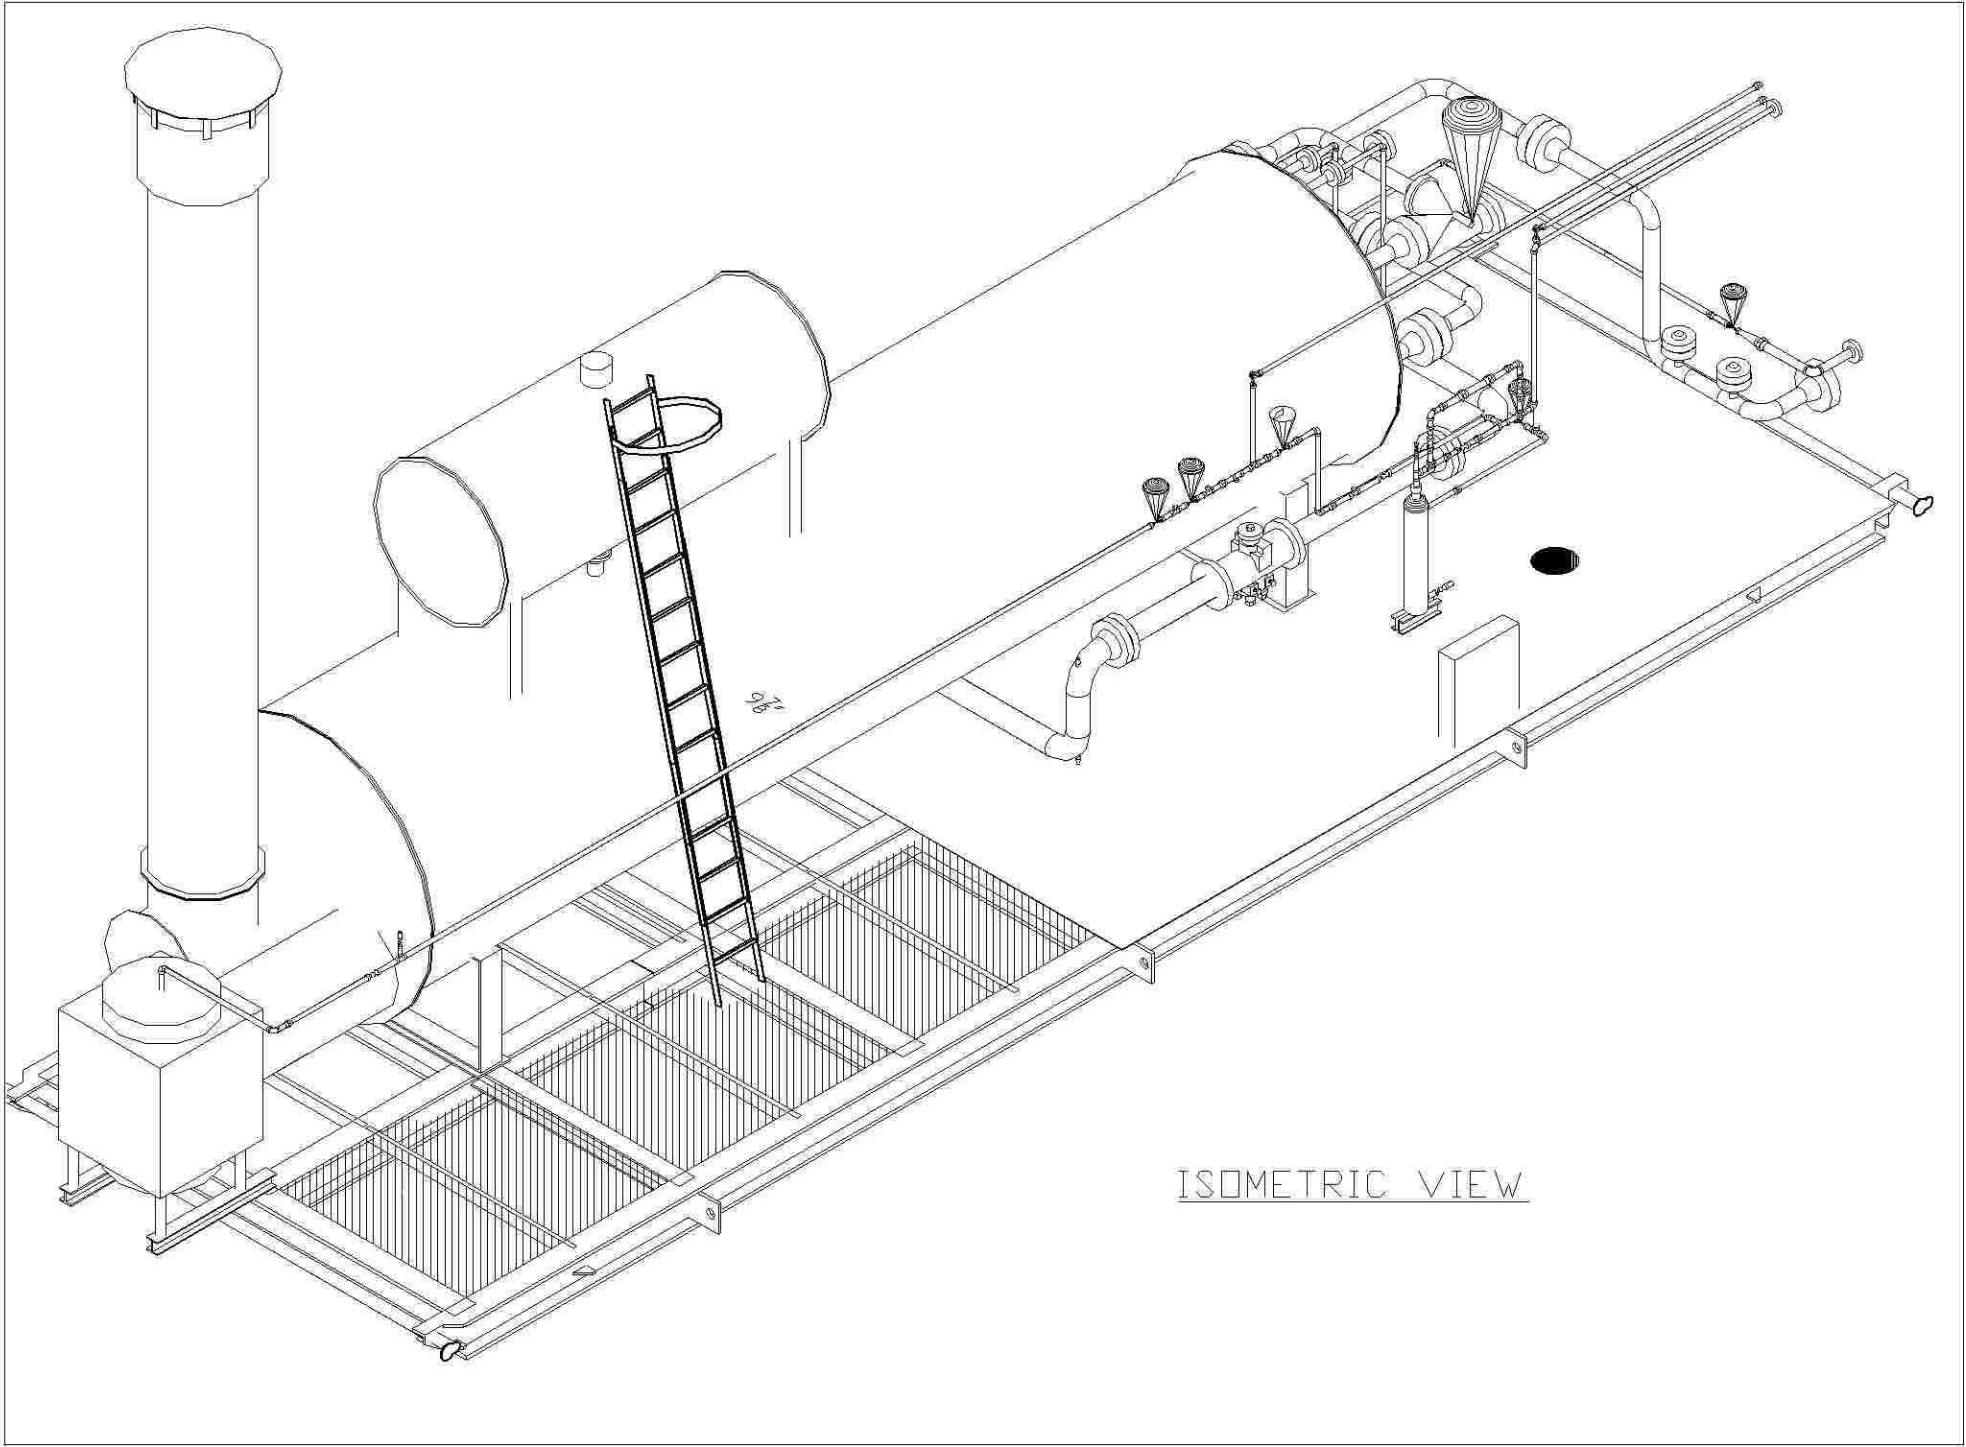



AS BUILT
Chatter

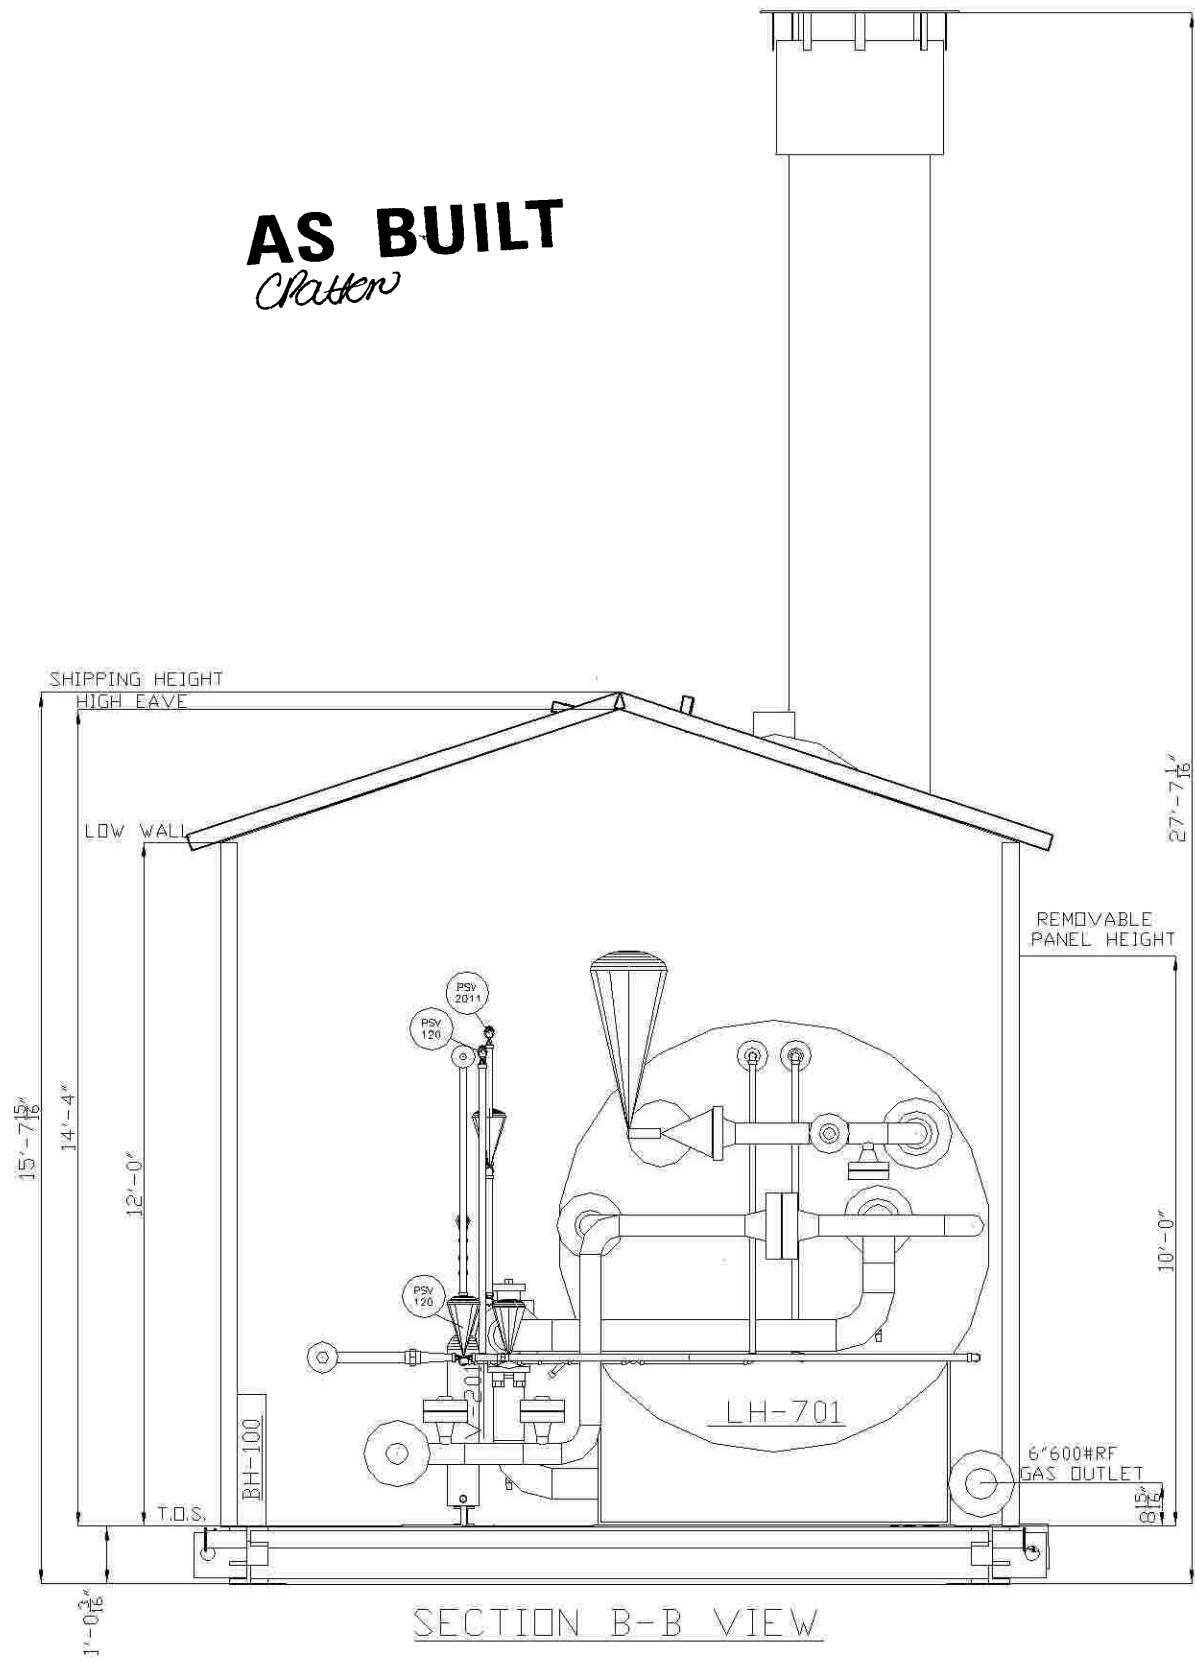

ENGINEERS & PERMIT STAMPS						<div>Paintearth</div> <div>ENERGY SERVICES INC.</div>	DATE 07-01-04		CLIENT BURLINGTON RESOURCES c/o SPEC ENGINEERING INC. LSD: 04-34-52-26 W3M	
							DESIGNED BY PES		TITLE 3.75 MM BTU LINEHEATER c/w 24'-0" LONG x 14'-0" WIDE BUILDING	
							DRAWN BY C.PRICHARD		PROJECT NO. 6119-001	
							CHECKED BY		FILENAME 6119-001GAISO	
							APPROVED BY		REFERENCE NO.	
							SCALE N.T.S.		SHEET NO. 2 OF 2	
									DRAWING NO. PES-6119-001GAISOB	
									REV. NO. 4	