

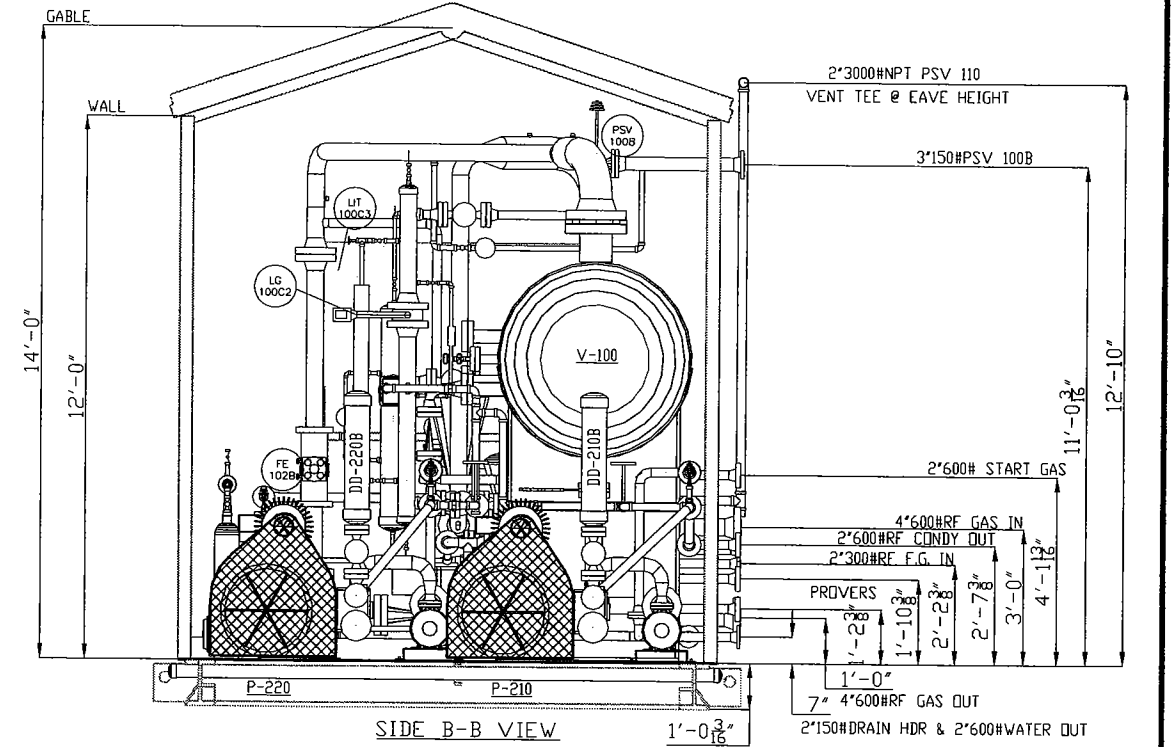


AS BUILT

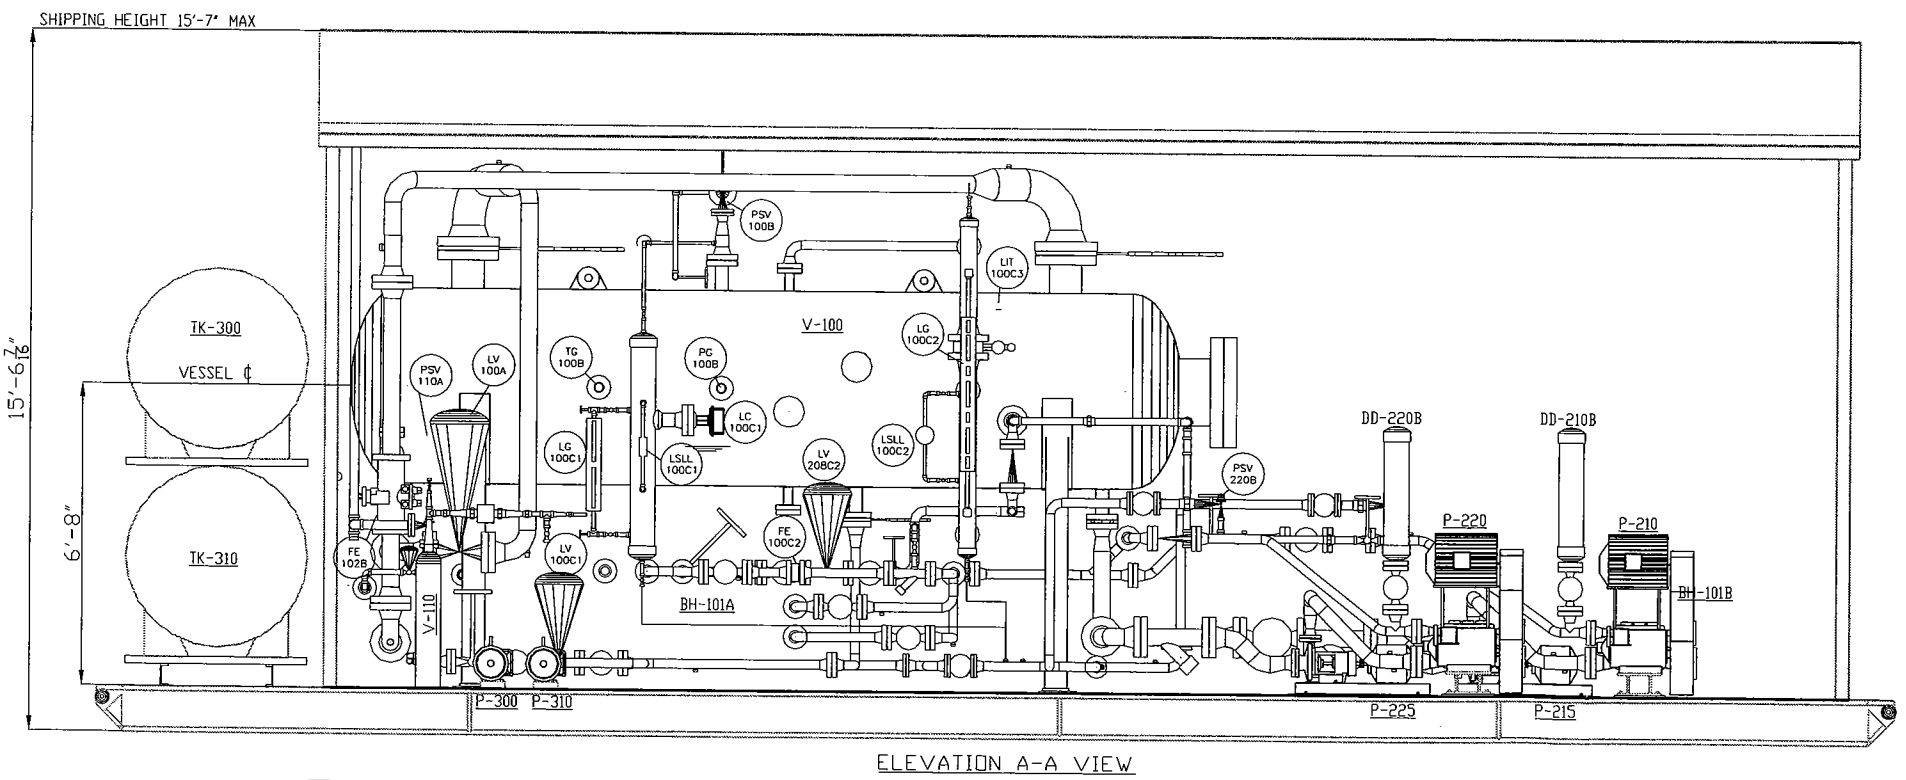

| ENGINEERS & PERMIT STAMPS |                                     |     |      |          |
|---------------------------|-------------------------------------|-----|------|----------|
| 2                         | AS BUILT                            | CP  |      | 06-08-31 |
| 1                         | ADD PUMP RECYCLE LINES PER CUSTOMER | CP  |      | 06-06-19 |
| 0                         | ISSUED FOR CONSTRUCTION             | LG  |      | 06-05-19 |
| C                         | REV. AS PER CUSTOMER                | PP  |      | 06-05-09 |
| B                         | REV. AS PER CUSTOMER                | PP  |      | 06-05-01 |
| A                         | ISSUED FOR APPROVAL                 | PP  |      | 06-04-12 |
| NO.                       | REVISIONS                           | DWN | APPR | DATE     |

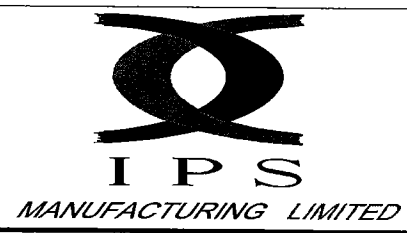

|                    |   |
|--------------------|---|
| DATE<br>06-04-12   | CLIENT<br>HUSKY ENERGY LIMITED<br>c/o TARTAN ENGINEERING LTD.<br>LSD: ANSELL 03-06-049-18 W5M |
| DESIGNED BY<br>IPS | TITLE<br>GENERAL ARRANGEMENT DRAWING FOR<br>48\"/>  |
| DRAWN BY<br>P.PIOT | PROJECT NO.<br>5325-001   |
| CHECKED BY<br>CWP  | FILENAME<br>5325-001GAISO   |
| APPROVED BY        | REFERENCE NO.   |
| SCALE<br>N.T.S.    | SHEET NO.<br>1 OF 1   |
|                    | DRAWING NO.<br>CCL- 5325-001GAISO   |
|                    | REV. NO.<br>2   |