


THE INFORMATION CONTAINED HEREIN IS THE CONFIDENTIAL PROPERTY OF TOROMONT PROCESS SYSTEMS AND IS NOT FOR PUBLICATION, AND NO PART THEREOF SHALL BE COPIED OR COMMUNICATED TO A THIRD PARTY WITHOUT AUTHORIZATION FROM TOROMONT PROCESS SYSTEMS.

NOZZLE SCHEDULE					
MARK	SERVICE	SIZE	RATING	TYPE	CUSTOMER TIE POINT
A1	GAS INLET	3"	300#	RFWN	YES
A2	GAS OUTLET	2"	300#	RFSW	YES
A3	LIQUID DRAIN	3/4"	3000#	NPT	YES
A4	VENT TO ATMOSPHERE	1"	-	STUB	NO
A5	STARTER/PSV VENT	2"	-	STUB	NO
A6	ENGINE EXHAUST	4"	-	STUB	NO
A7	ENGINE AIR INLET	3"	-	STUB	NO

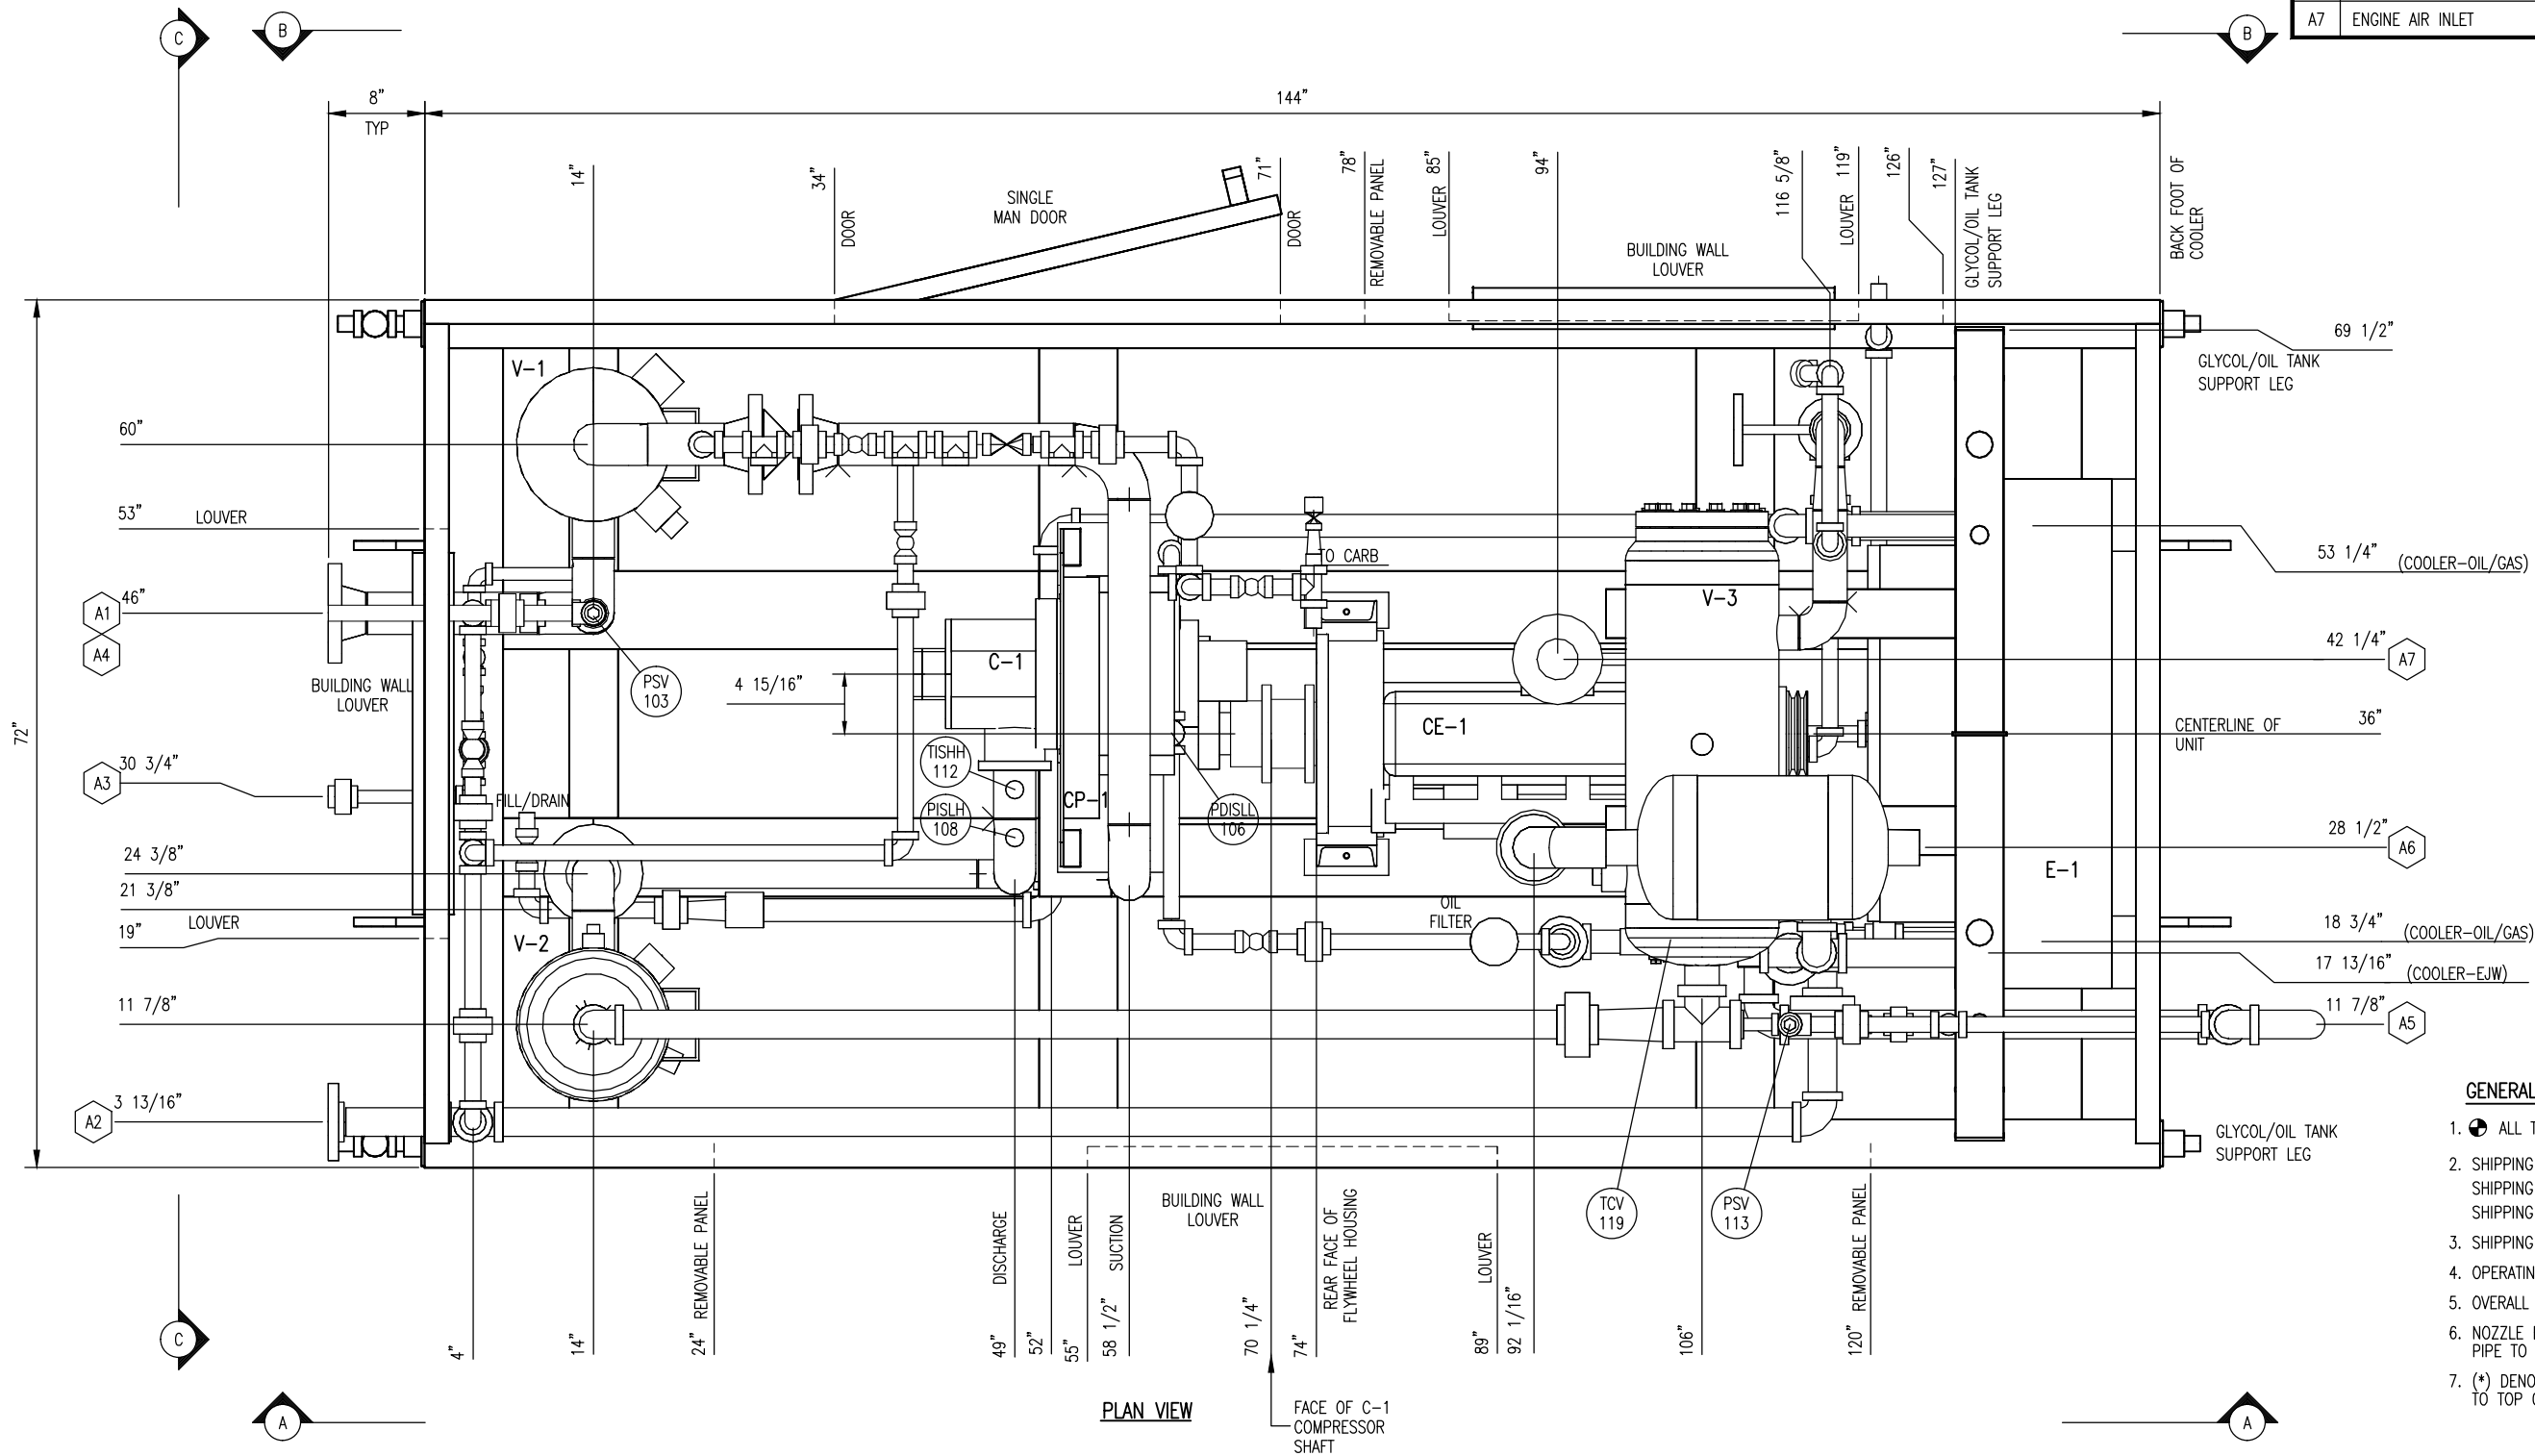

**GENERAL NOTES:**

- ALL TAIL DIMENSIONS FROM REFERENCE POINT.
- SHIPPING LENGTH 158"  
SHIPPING WIDTH 78"  
SHIPPING HEIGHT 120"
- SHIPPING WEIGHT 9200 LBS
- OPERATING WEIGHT 9456 LBS
- OVERALL SKID DEPTH: 8 3/16"
- NOZZLE ELEVATIONS ARE FROM CENTERLINE OF PIPE TO TOP OF BASE (REFERENCE POINT).
- (\*) DENOTES ELEVATION FROM FACE OF FLANGE TO TOP OF BASE (REFERENCE POINT).

REV.	DESCRIPTION	DATE	BY	APPR.
2	AS BUILT	MAY 6/03	CD	
1	ISSUED FOR CONSTRUCTION	FEB 19/03	CD	GS


PERMIT TO PRACTICE STAMP	ENGINEER STAMP
--------------------------	----------------




DRAWN BY: C. DAVIDSON	DATE: FEB 7/03
CHKD. BY: G. SCHUSTER	SCALE: 1 1/2"=1'-0"
APPR. BY: G. SCHUSTER	W.O. No: 11132201
CUST. PO No:	

TITLE: <b>GENERAL ARRANGEMENT</b>
FOR: TOROMONT PROCESS SYSTEMS 60 HP WELLHEAD BOOSTER
DWG. No: 11132-201
SHEET No: 1 OF 3
REV: 2

THE INFORMATION CONTAINED HEREIN IS THE CONFIDENTIAL PROPERTY OF TOROMONT PROCESS SYSTEMS AND IS NOT FOR PUBLICATION, AND NO PART THEREOF SHALL BE COPIED OR COMMUNICATED TO A THIRD PARTY WITHOUT AUTHORIZATION FROM TOROMONT PROCESS SYSTEMS.

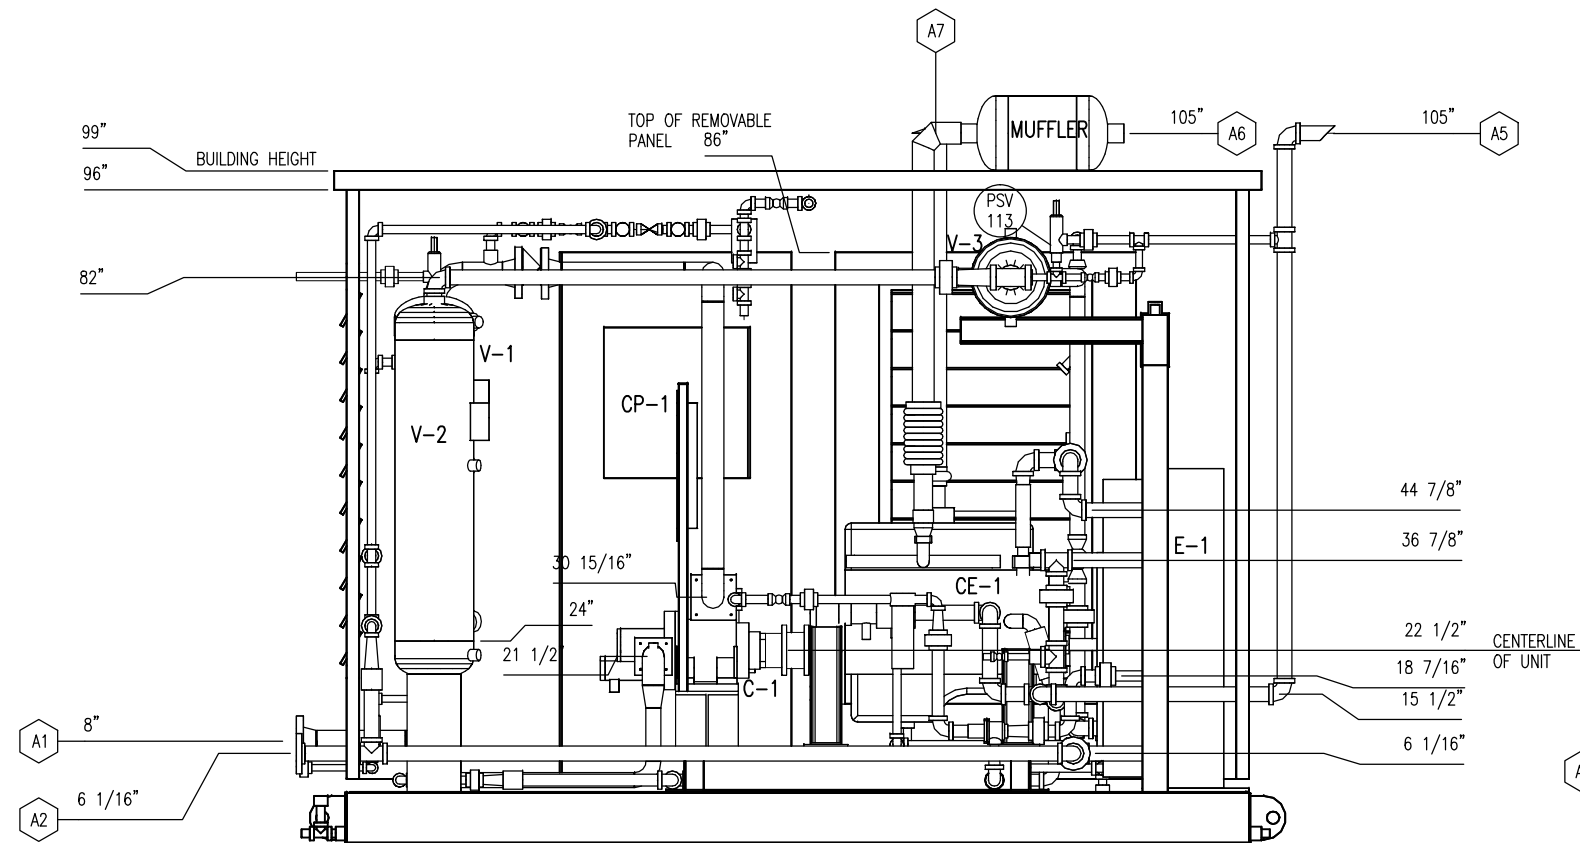

ELEVATION VIEW "A-A"

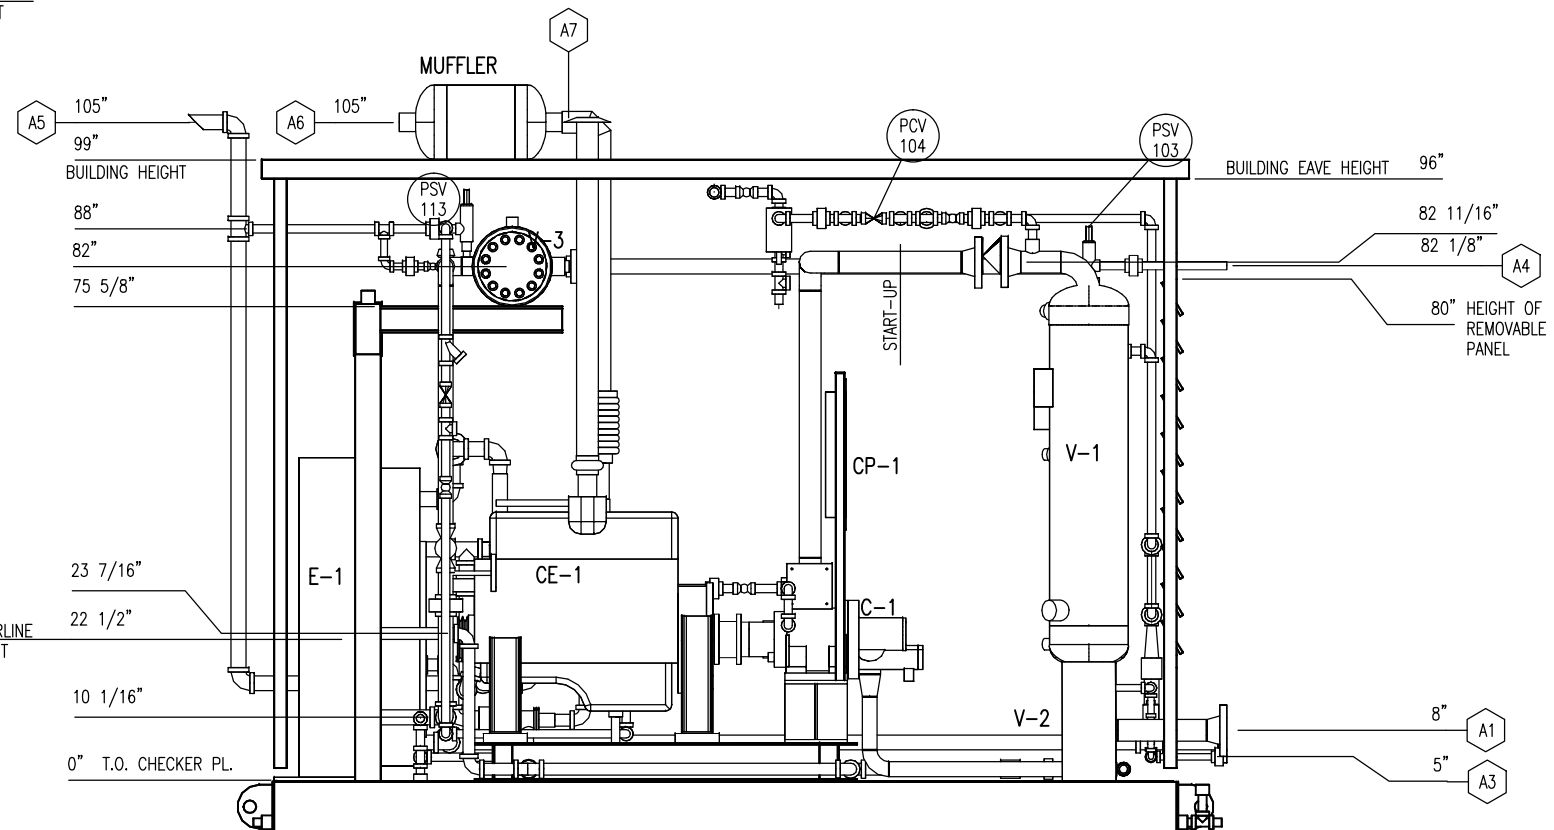


ELEVATION VIEW "B-B"

REV.	DESCRIPTION	DATE	BY	APPR.
2	AS BUILT	MAY 6/03	CD	
1	ISSUED FOR CONSTRUCTION	FEB 19/03	CD	GS

PERMIT TO PRACTICE STAMP	ENGINEER STAMP
--------------------------	----------------

<b>TOROMONT</b>	<b>TOROMONT PROCESS SYSTEMS</b>	TITLE: ELEVATIONS
DRAWN BY: C. DAVIDSON CHKD. BY: G. SCHUSTER APPR. BY: G. SCHUSTER CUST. PO No:		DATE: FEB 7/03 SCALE: 3/4"=1'-0" W.O. No: 11132201
FOR: TOROMONT PROCESS SYSTEMS 60 HP WELLHEAD BOOSTER		DWG. No: 11132-201 SHEET No: 2 OF 3 REV: 2

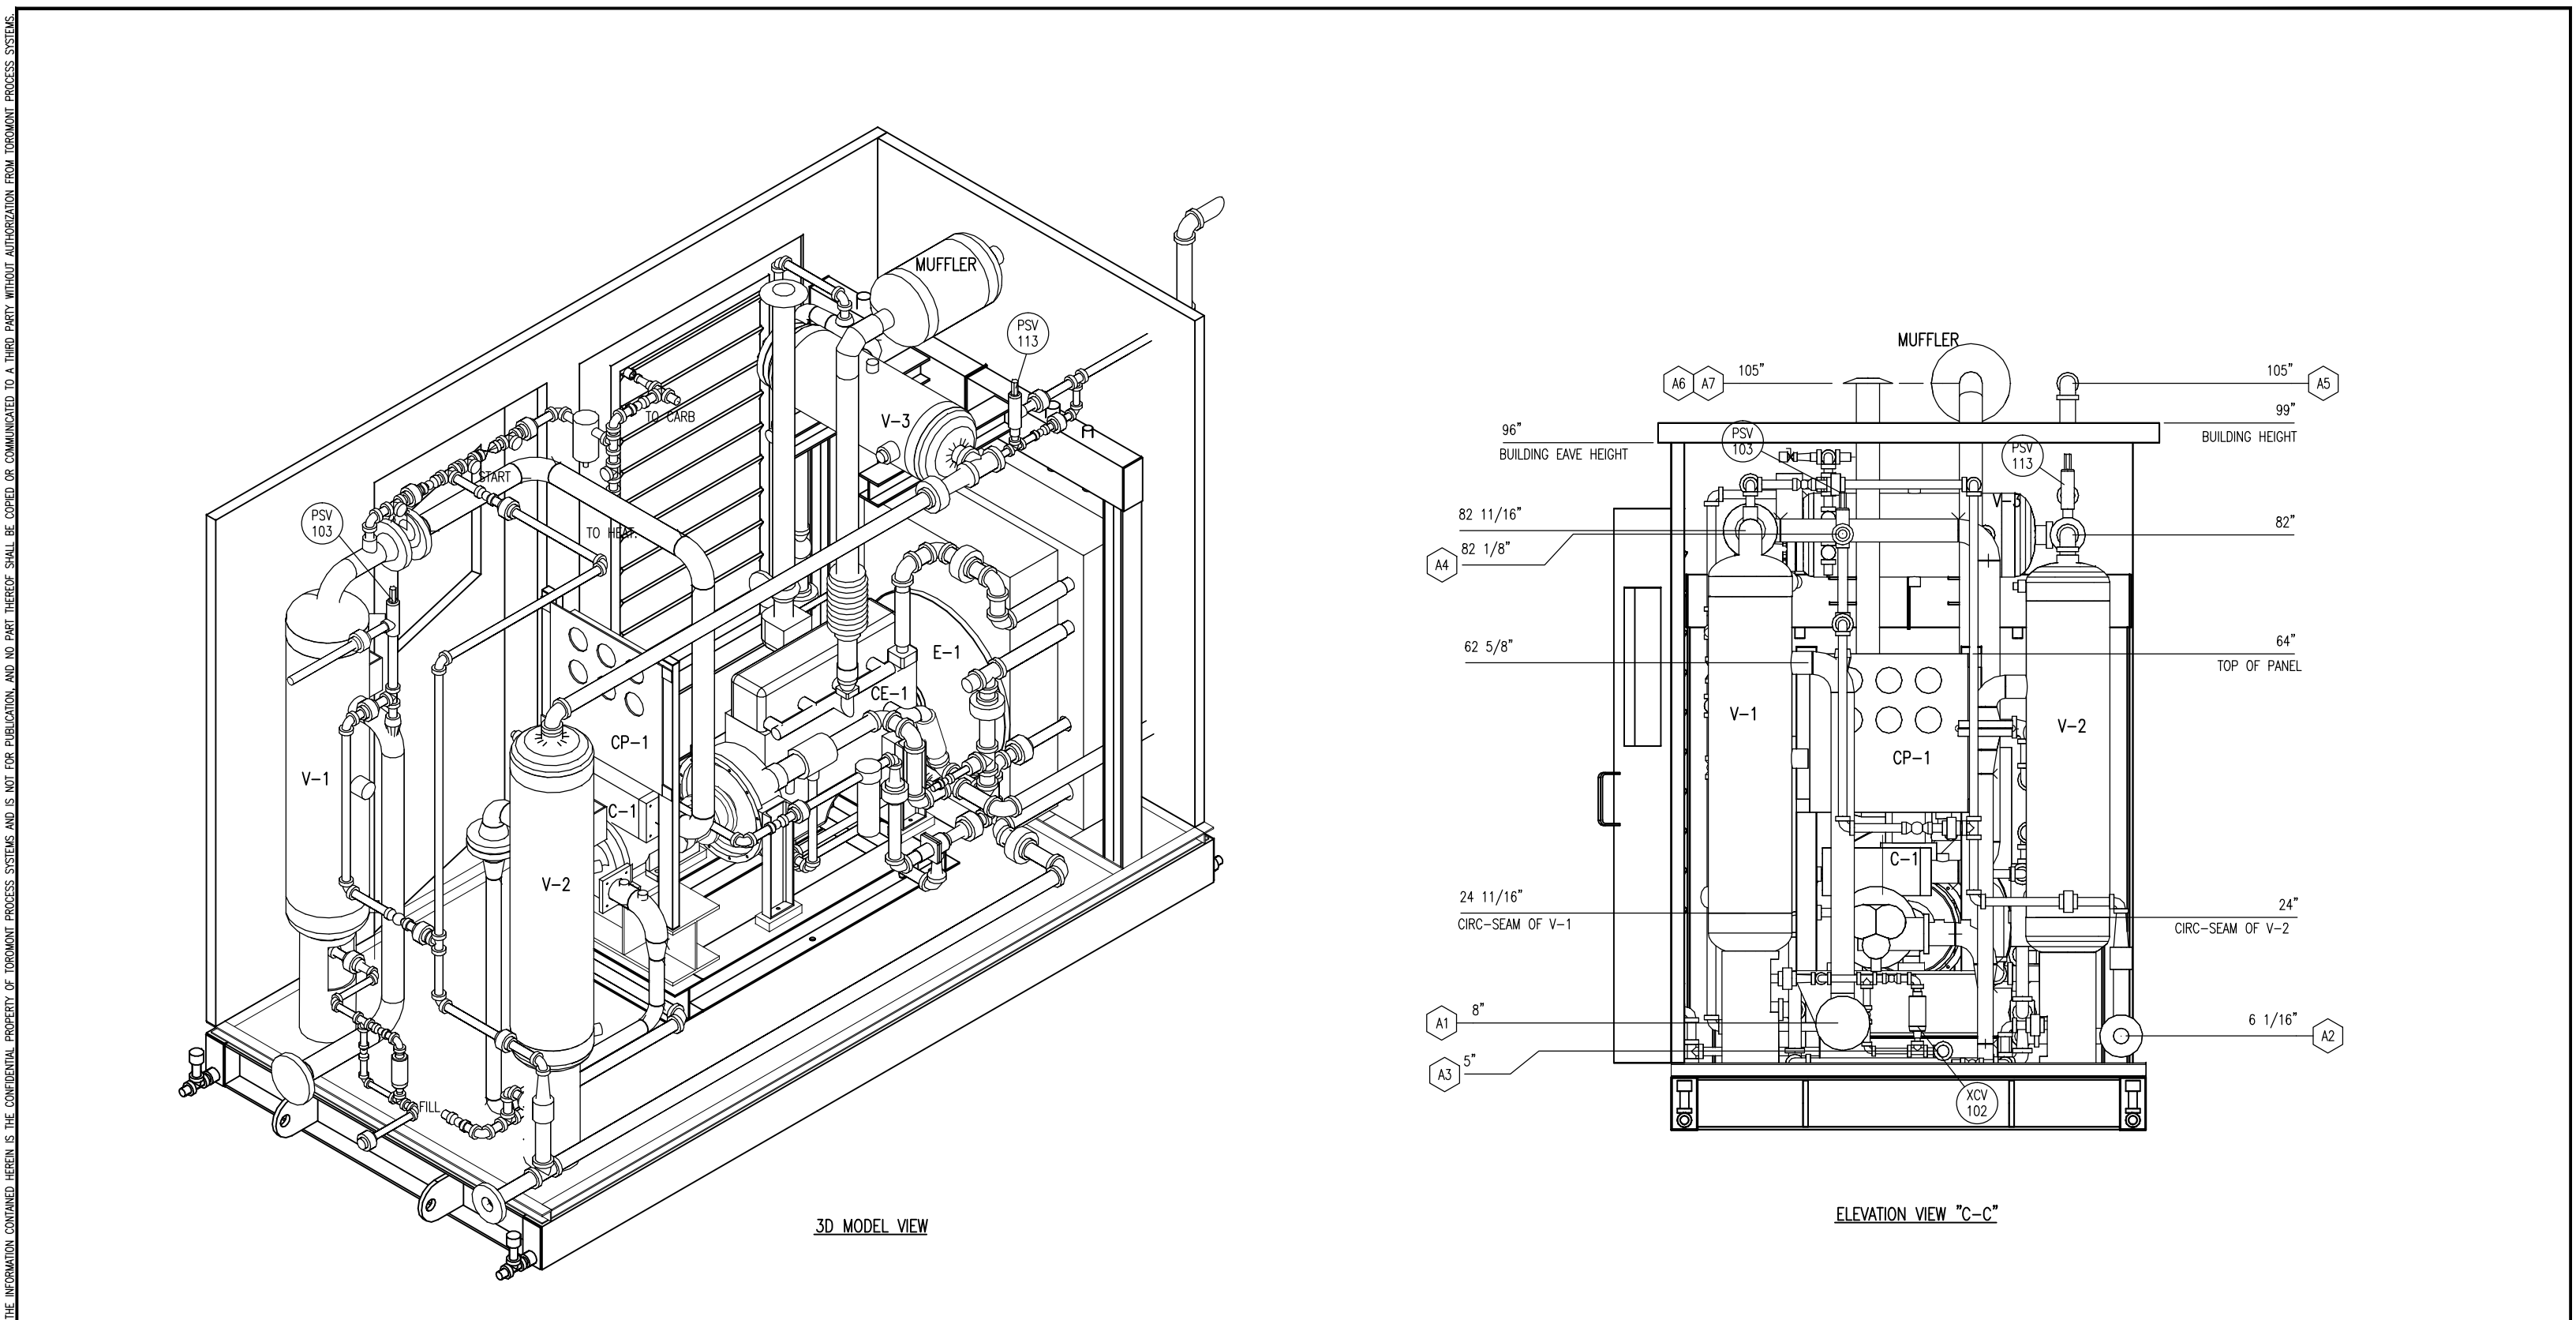

REV.	DESCRIPTION	DATE	BY	APPR.
2	AS BUILT	MAY 6/03	CD	
1	ISSUED FOR CONSTRUCTION	FEB 19/03	CD	GS

PERMIT TO PRACTICE STAMP	ENGINEER STAMP
--------------------------	----------------



DRAWN BY: C. DAVIDSON	DATE: FEB 7/03
CHKD. BY: G. SCHUSTER	SCALE: 1"=1'-0"
APPR. BY: G. SCHUSTER	W.O. No: 11132201
CUST. PO No:	

TITLE: 3D MODEL/END VIEWS
FOR: TOROMONT PROCESS SYSTEMS 60 HP WELLHEAD BOOSTER
DWG. No: 11132-201
SHEET No: 3 OF 3
REV: 2