



REVISIONS						
ZONE	REV	ECN	DESCRIPTION	DATE	DRAWN	APPD
	A	ENL05082	ORIGINAL RELEASE	25JUL11	R.PATADIA	P.SHAH
	B	ENL05119	REVISED AS PER CUSTOMER'S COMMENTS	19AUG11	R.PATADIA	P.SHAH
	C	ENL05391	AS BUILT	23JAN12	A.GADARA	P.SHAH

ITEM	DESCRIPTION	SIZE / LEGEND
A1	INLET FLANGE CONNECTION	3" - 300# WNRF
A2	PRIMARY AIR DISCHARGE CONN. (HOT)	2.5" - 600# WNRF
A3	ALTERNATE AIR DISCHARGE CONN. (BLIND)	3" - 600# WNRF
B	SPACE REQUIRED TO REMOVE PISTON AND ROD	AS SHOWN
D	OIL DRAIN CONNECTION-FRAME (PLUGGED)	0.50" NPT
G	REGULATION CONNECTION	0.50" NPT
H2	CONDEN SATE CONNECTION (FIRST STAGE SEPERATOR)	0.50" NPT
H4	CONDEN SATE CONNECTION (SECOND STAGE SEPERATOR)	0.50" NPT
J	60/40 EG/WATER INLET	1.5" NPT
K	60/40 EG/WATER OUTLET	1.5" NPT
PSV-1	PRESSURE RELIEF VALVE (PSV-9810)	130 PSIG
PSV-2	PRESSURE RELIEF VALVE (PSV-9812)	290 PSIG
PSV-3	PRESSURE RELIEF VALVE (PSV-9813)	980 PSIG

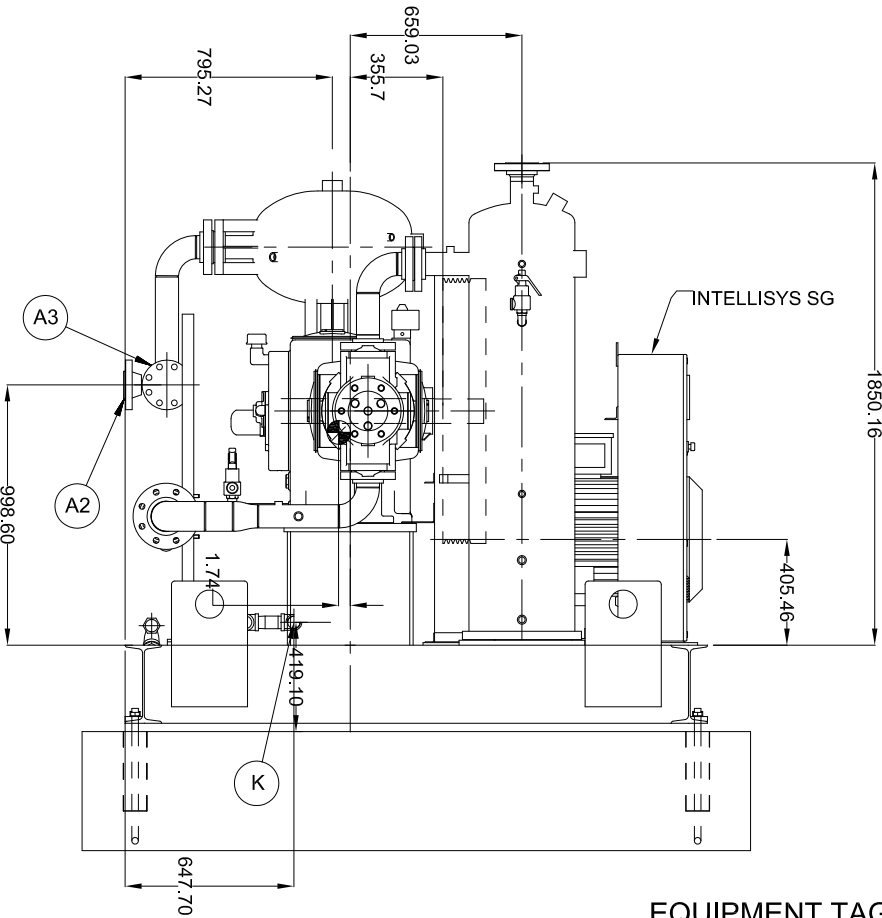

EQUIPMENT TAG#: K-9810

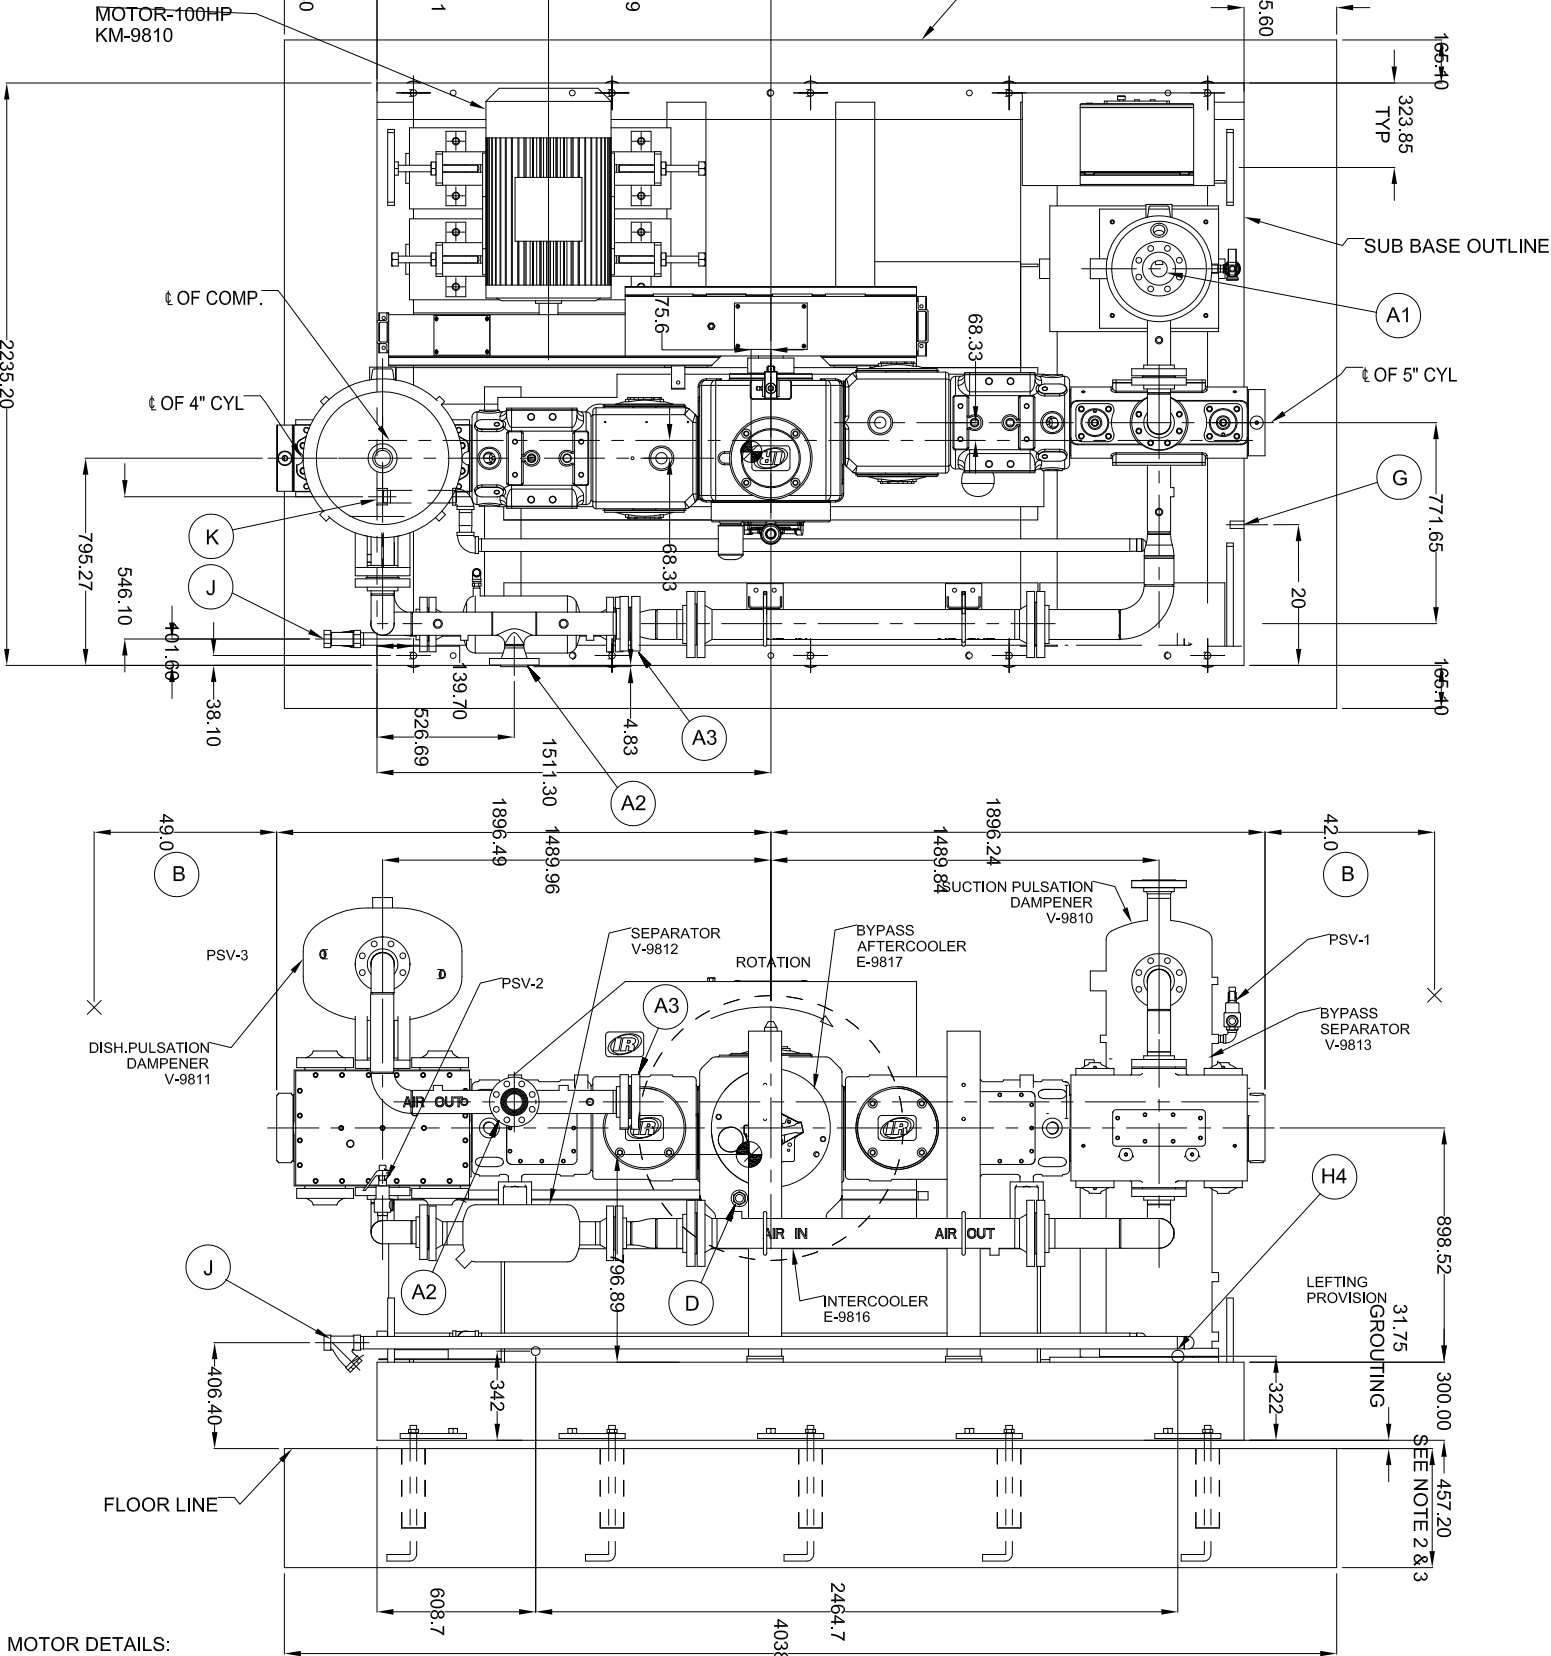

MOTOR DETAILS:

1. MOTOR RATING : 100HP/460V/3PH/60HZ
2. SPEED : 1775 RPM







V BELT DRIVE DETAIL					
NO OF BELTS	SIZE OF BELT	OD OF MOTOR PULLEY	OD OF COMP. SHEAVE	COMP. SPEED	CD OF DRIVE
5	5VX-160	8.4"	40"	369	33.59

STANDARD TOLERANCES ALL DIMENSIONS ARE IN MILLIMETERS [INCHES (IF SHOWN)] UNSPECIFIED TOLERANCES: WHOLE : ±1 ONE PLACE (X) : ±0.5 TWO PLACE (XX) : ±0.25 ANGLES (X) : ±1°	WARNING: THE EXPORT OR REEXPORT OF THIS DRAWING OR A PRODUCT PRODUCED BY THIS DRAWING IS SUBJECT TO U.S. EXPORT ADMINISTRATION REGULATIONS AND OTHER APPLICABLE GOVERNMENT RESTRICTIONS OR REGULATIONS.
	PROPRIETARY NOTICE THIS DRAWING CONTAINS CONFIDENTIAL AND TRADE SECRET INFORMATION, IS THE PROPERTY OF INGERSOLL-RAND CO., AND IS GIVEN TO THE RECEIVER IN CONFIDENCE. THE RECEIVER BY RECEPTION AND RETENTION OF THE DRAWING ACCEPTS THE DRAWING IN CONFIDENCE AND AGREES THAT, EXCEPT AS AUTHORIZED IN WRITING BY INGERSOLL-RAND CO., IT WILL (1) NOT USE THE DRAWING OR ANY COPY THEREOF OR THE CONFIDENTIAL OR TRADE SECRET INFORMATION THEREIN; (2) NOT COPY THE DRAWING; (3) NOT DISCLOSE TO OTHERS EITHER THE DRAWING OR THE CONFIDENTIAL OR TRADE SECRET INFORMATION THEREIN; AND (4) UPON COMPLETION OF THE NEED TO RETAIN THE DRAWING, OR UPON DEMAND, RETURN THE DRAWING, ALL COPIES THEREOF, AND ALL MATERIAL COPIED THEREFROM.

DO NOT SCALE DRAWING DRAWING CONFORMS TO ASME Y14.5M - 1994 CAD GENERATED DRAWING, NO MANUAL REVISIONS ALLOWED UNLESS OTHERWISE SPECIFIED: - REMOVE ALL BURRS AND SHARP CORNERS - WELD SYMBOLS TO BE IN ACCORDANCE WITH ANSI/AWS A2.4 COPYRIGHT © 2012 Ingersoll Rand ALL RIGHTS RESERVED

THIRD ANGLE PROJECTION	
DRAWN R.PATADIA	DATE 25JUL11
CHECKED P.SHAH	DATE 25JUL11
APPROVED D.PATIL	DATE 25JUL11
NOMENCLATURE	

		TITLE GENERAL ARRANGEMENT & FOUNDATION PLAN	
SIZE A1	ESTIMATED WEIGHT (INCLUDES SHIPPING WEIGHT)	DWG NO. 23924541	REV C
SCALE: 0.08	UNIT:	SHEET	1 OF 2

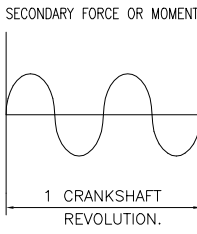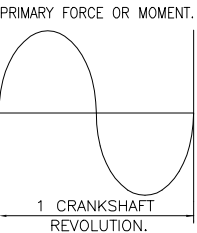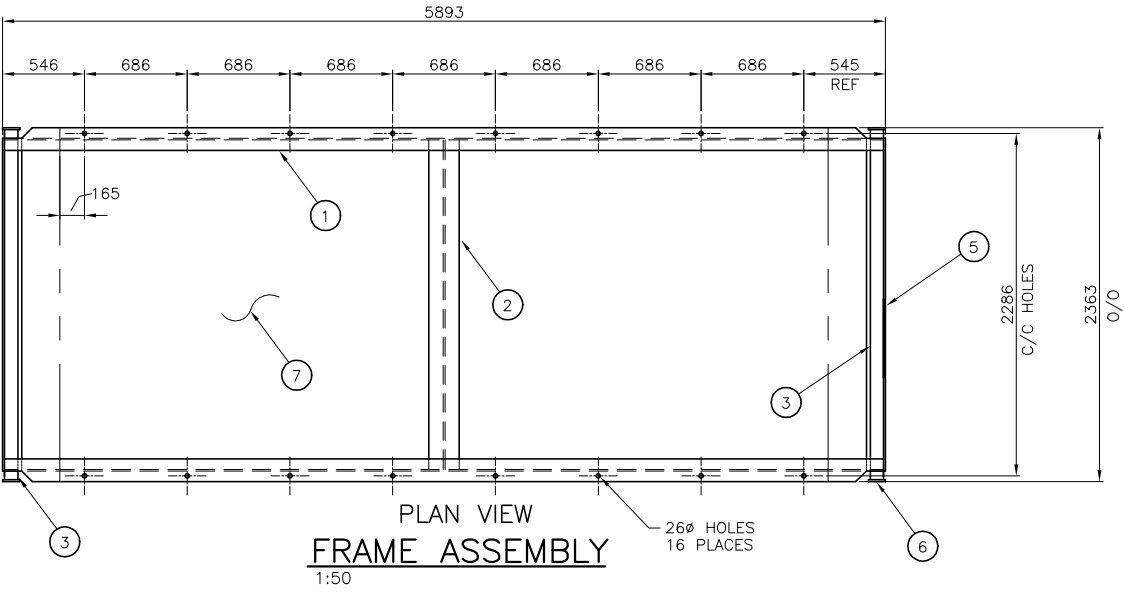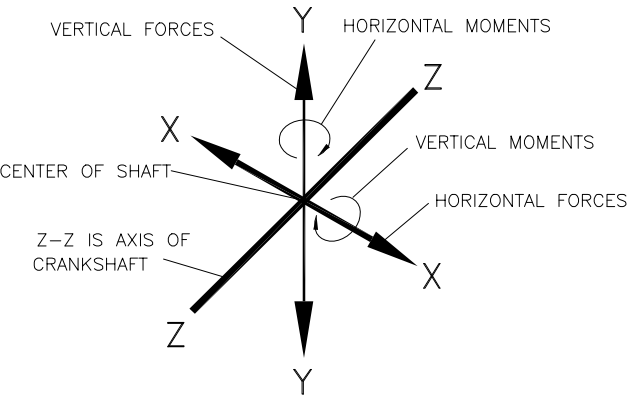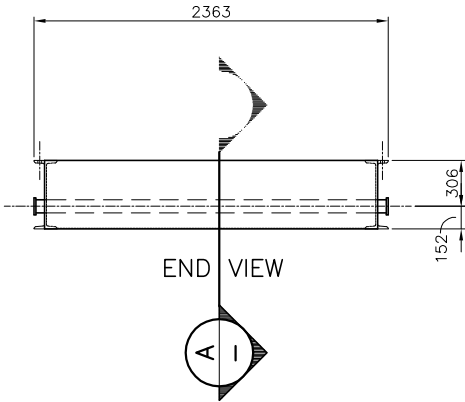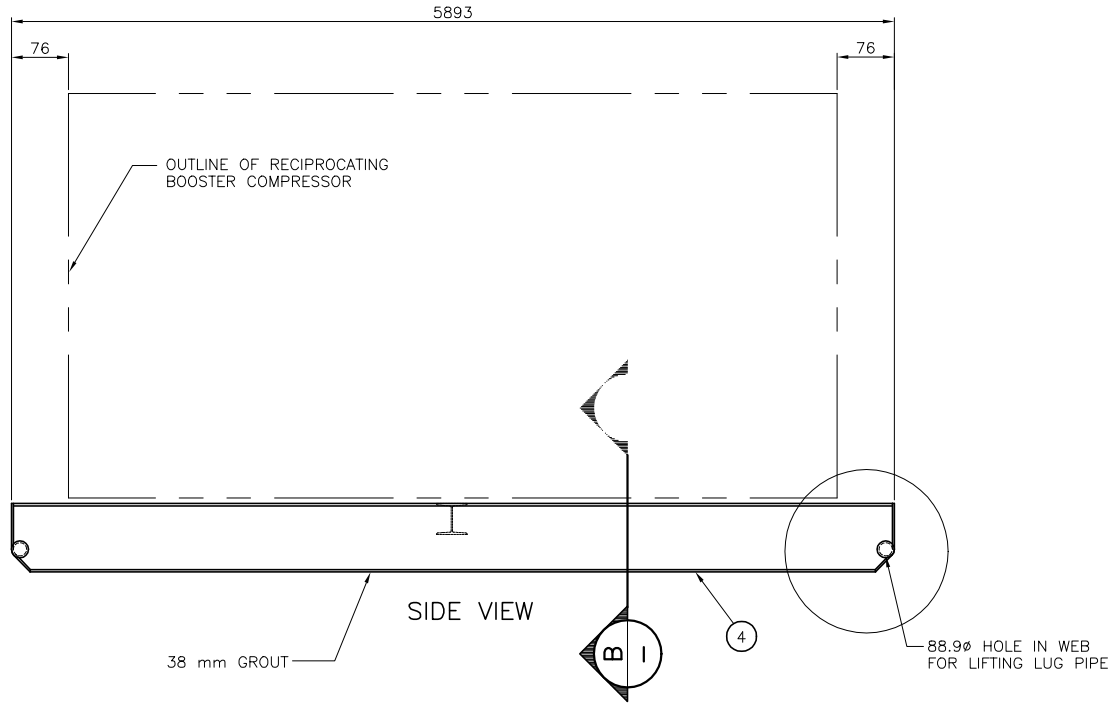

UNBALANCED INERTIA FORCES ON FOUNDATION


THE FOUNDATION MUST BE DESIGNED TO RESIST THE FOLLOWING FORCES :

- MAXIMUM HORIZONTAL PRIMARY FORCE_____1383 _LBS.
- MAXIMUM HORIZONTAL SECONDARY FORCE_____267 _LBS.
- MAXIMUM VERTICAL PRIMARY FORCE_____0 _LBS.
- MAXIMUM VERTICAL SECONDARY FORCE_____0 _LBS.
- MAXIMUM HORIZONTAL PRIMARY MOMENT (ABOUT AXIS Y-Y)_____6429_LBS.FT.
- MAXIMUM HORIZONTAL SECONDARY MOMENT (ABOUT AXIS Y-Y)_____941_LBS.FT.
- MAXIMUM VERTICAL PRIMARY MOMENT (ABOUT AXIS X-X)_____1553 _LBS.FT.
- MAXIMUM VERTICAL SECONDARY MOMENT (ABOUT AXIS X-X)_____0 _LBS.FT.

NOTES :

- 1 : MOMENTS TAKEN ABOUT AXIS THROUGH CENTER OF SHAFT. FORCES TAKEN AS ACTING AT CENTER OF SHAFT.
- 2 : PRIMARY FORCES & MOMENTS CHANGE FROM ZERO TO MAXIMUM GIVEN ABOVE TO ZERO TO SAME MAXIMUM IN REVERSE DIRECTION & BACK TO ZERO ONCE IN A CRANKSHAFT REVOLUTION. SECONDARY FORCES & MOMENTS GO THROUGH THIS CYCLE TWICE IN A REVOLUTION. THE SKETCH SHOWS THIS.

7	1	1360 Kg CONCRETE	6.5 CUBIC METERS
6	4	LIFTING LUG END CAP	A53 PLATE 127øx13
5	2	TUB END PLATE	A53 PLATE 2223x508x13
4	1	TUB BOTTOM	A53 STEEL PLATE 2184x5867x6
3	2	LIFTING LUG	80ø, SCH 80 A53 PIPE @ 2337 LONG
2	1	CROSS BRACE	W200x52 @ 2200mm LONG
1	2	SIDE RAILS	S460x81.4 @ 6096mm LONG
Item	Qty.	Description	Reference
BILL OF MATERIALS			

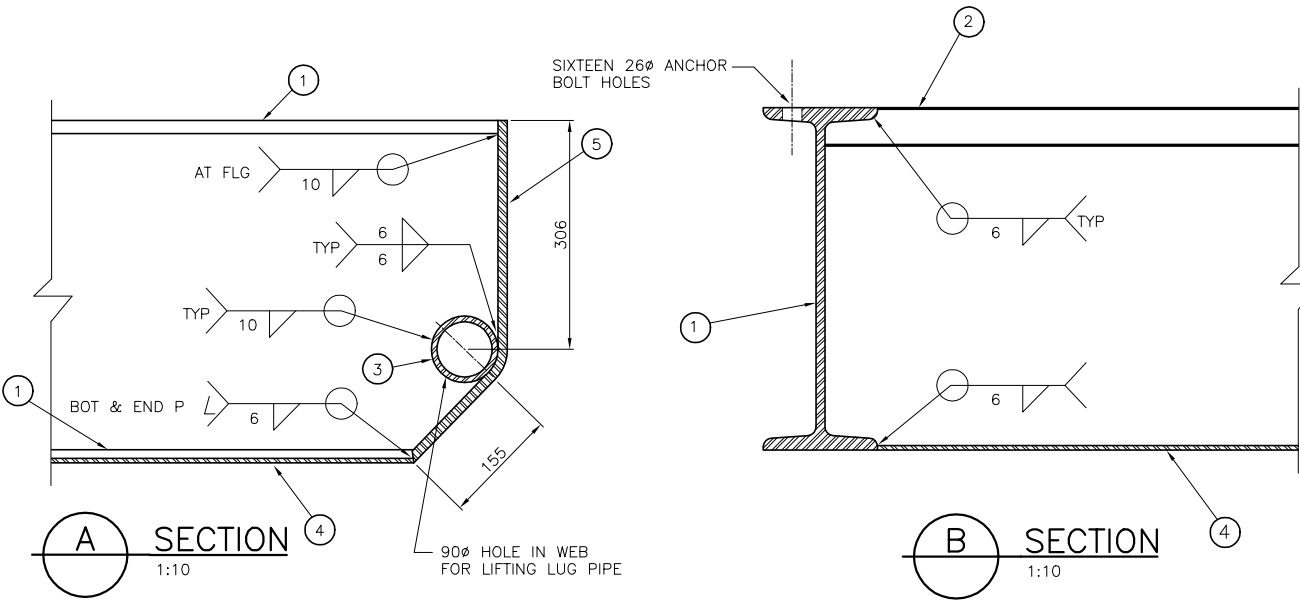

CAD GENERATED DRAWING,
NO MANUAL REVISIONS ALLOWED

WARNING:
THE EXPORT OR RE-EXPORT OF THIS DRAWING
OR A PRODUCT PRODUCED BY THIS DRAWING
IS SUBJECT TO U.S. EXPORT ADMINISTRATION
REGULATIONS AND OTHER APPLICABLE
GOVERNMENTAL RESTRICTIONS OR REGULATIONS.

PROPRIETARY NOTICE

THIS DRAWING CONTAINS CONFIDENTIAL AND TRADE SECRET INFORMATION, IS THE PROPERTY OF INGERSOLL-RAND CO., AND IS GIVEN TO THE RECEIVER IN CONFIDENCE. THE RECEIVER BY RECEPTION AND RETENTION OF THE DRAWING ACCEPTS THE DRAWING IN CONFIDENCE AND AGREES THAT, EXCEPT AS AUTHORIZED IN WRITING BY INGERSOLL-RAND CO. IT WILL (1) NOT USE THE DRAWING OR ANY COPY THEREOF OR THE CONFIDENTIAL OR TRADE SECRET INFORMATION THEREIN; (2) NOT COPY THE DRAWING; (3) NOT DISCLOSE TRADE SECRET INFORMATION THEREIN; AND (4) UPON COMPLETION OF THE NEED TO RETAIN THE DRAWING, OR UPON DEMAND, RETURN THE DRAWING, ALL COPIES THEREOF, AND ALL MATERIAL COPIED THEREFROM

NOUN CODE

THIRD ANGLE PROJECTION

DRAWN: ASH

CHECKED: BR

APPROVED: BR

DATE: NOV 18 2007

DATE:

ALL DIMENSIONS IN MILLIMETERS U.N.O.

Air Force
Compressed Air Systems


Bay C, 3518-62nd Ave SE
Calgary, Alberta T2C 1Z8
Toll Free: 1-888-231-1024

TITLE

PLAN AND ELEVATIONS
BOOSTER AIR COMPRESSOR SKID K-903
WHITESANDS CONKLIN PILOT PROJECT - PHASE II
INJECTION AIR BOOSTER COMPRESSOR IR 2-STAGE MODEL PHE 7&4.5x9

SIZE	ESTIMATED WEIGHT	DRAWING No.	REV
B	18145 KG 40,000 LBS	AFPCS-1.2M03	0
SCALE	1:50	UNIT:	SHEET: 4 OF 15

REVISIONS					
REV	ECN	DESCRIPTION	DWN	APV	DATE
A	ENL05033	ORIGINAL RELEASE	PVS	DP	25JUN11
B	ENL05082	HOT DISCHARGE TAPPING ADDED	PVS	DP	25JUL11
C	ENL05119	REVISED AS PER CUST. COMMENTS	PVS	DP	16AUG11
D	ENL05161	REVISED AS PER CUST. COMMENTS	PVS	DP	15SEP11
E	ENL05161	REVISED AS PER CUST. COMMENTS	SRJ	GP	21JAN12
F	0	AS-BUILT	ASH	BG	24AUG12

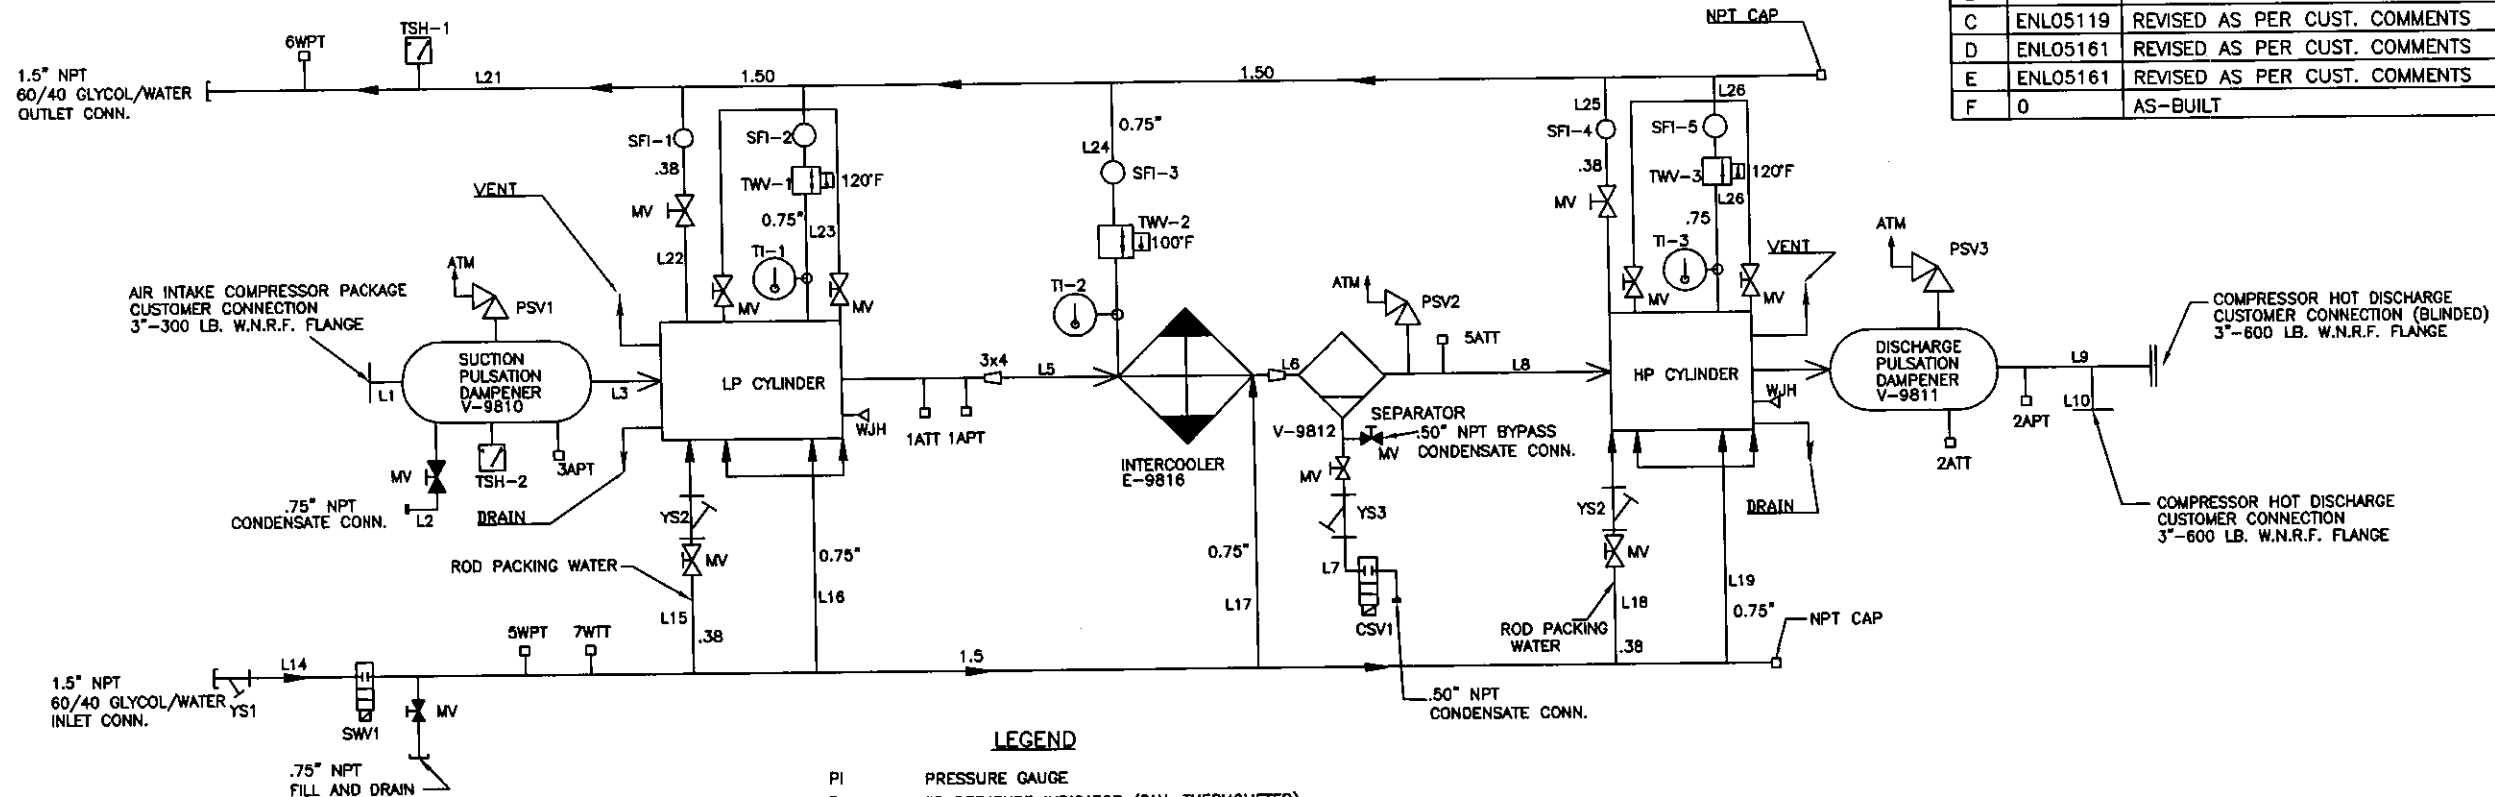


LEGEND

PI	PRESSURE GAUGE
TI	TEMPERATURE INDICATOR (DIAL THERMOMETER)
MV	MANUAL BALL VALVE
YS	STRAINER
PRV	PRESSURE REDUCING VALVE
PSV1/9810	PRESSURE RELIEF VALVE (SET AT 139 PSIG) 958 kPag
PSV2/9812	PRESSURE RELIEF VALVE (SET AT 300 PSIG) 2067 kPag
PSV3/9811	PRESSURE RELIEF VALVE (SET AT 1100 PSIG) 7577 kPag
PSV4/9814	PRESSURE RELIEF VALVE (SET AT 90 PSIG) 620 kPag
SFI	SIGHT FLOW INDICATOR
SWV	SOLENOID WATER VALVE
TWV	THERMOSTATIC WATER CONTROL VALVE
UNL-1	SOLENOID UNLOADER VALVE (1ST STEP UNLOADING)
UNL-2	SOLENOID UNLOADER VALVE (2ND STEP UNLOADING)
CSV	CONDENSATE SOLENOID VALVE
CH	CRANK CASE HEATER
WJH	CYLINDER WATER JACKET HEATER



INTELLISYS CONTROL - LEGEND

1APT	1ST STAGE DISCHARGE AIR PRESSURE
1ATT	1ST STAGE DISCHARGE AIR TEMPERATURE
2APT	PACKAGE DISCHARGE AIR PRESSURE
2ATT	2ND STAGE DISCHARGE AIR TEMPERATURE
3APT	SUCTION PRESSURE
3OTT	FRAME OIL TEMPERATURE
4OPT	FRAME OIL PRESSURE
5WPT	PACKAGE INLET WATER PRESSURE
5ATT	2ND STAGE INLET AIR TEMPERATURE
6WPT	PACKAGE OUTLET WATER PRESSURE
7WTT	PACKAGE INLET WATER TEMPERATURE
TSH-1	PACKAGE WATER OUTLET TEMPERATURE
TSH-2	PACKAGE AIR INLET TEMPERATURE

→	AIR FLOW
→	WATER FLOW
→	CONDENSATE CONNECTION
→	REGULATION AIR

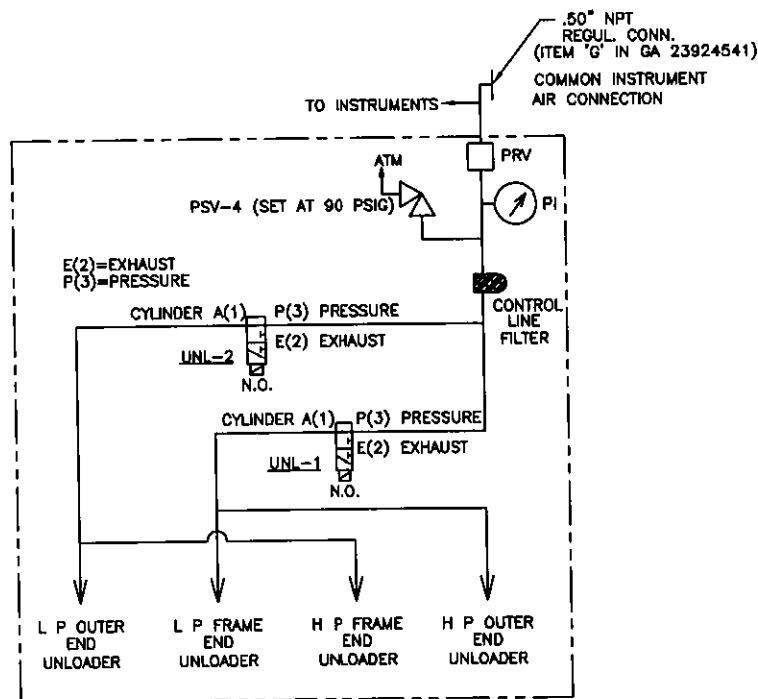

REGULATION SYSTEM

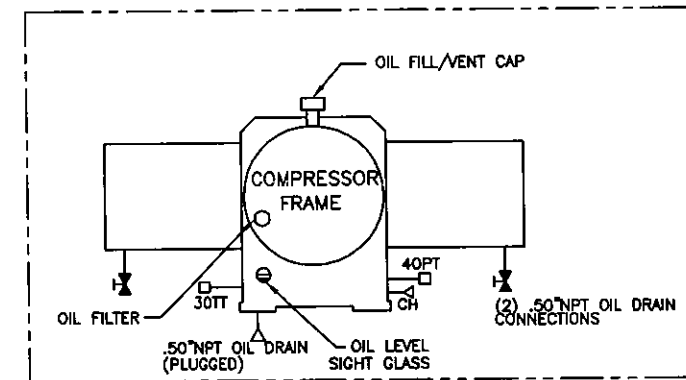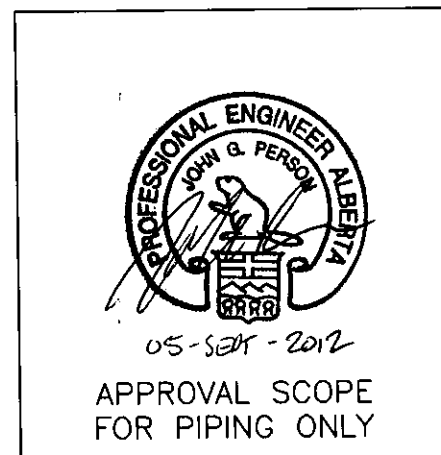

OIL SYSTEM

NOTES:

- 1) SUCTION PRESSURE CANNOT EXCEED 165 PSIG.
- 2) ALL WATER PIPING LINES TO BE PROVIDED WITH HIGH POINT VENTS AND LOW POINT DRAINS.
- 3) SEE AX-2172 FOR CLOSED LOOP COOLING SYSTEM DIRECTIVE.
- 4) DO NOT COMBINE CONDENSATE DRAIN & BYPASS LINE. THESE LINES SHOULD BE OPEN TO ATMOSPHERIC PRESS.
- 5) REFER SHEET 2 FOR LINE SCHEDULE & TAG NO.

RC 20.11 23908379 REV 5/13/11

K9810- RECIP ROTATING COMPRESSOR

COPYRIGHT © 2001 INGERSOLL-RAND COMPANY ALL RIGHTS RESERVED DRAWING CONFORMS TO ASME Y14.5M - 1994		WARNING: THE DESIGN OR REPORT OF THIS ENGINE OR A PRODUCT PRODUCED BY THIS ENGINE IS SUBJECT TO U.S. EXPORT ADMINISTRATION REGULATIONS AND OTHER APPLICABLE GOVERNMENTAL RESTRICTIONS OR REGULATIONS.		MICROFILM BLOWNUP SCALE 1" = 1'		INgersoll Rand Industrial Technologies	
PROPRIETARY NOTICE THIS DOCUMENT CONTAINS CONFIDENTIAL AND TRADE SECRET INFORMATION, IS THE PROPERTY OF INGERSOLL-RAND COMPANY, AND IS LOANED TO THE RECIPIENT IN CONFIDENCE. THE RECIPIENT BY RECEIVING AND RETENTION OF THE DOCUMENT ACCEPTS THE DOCUMENT IN CONFIDENCE AND AGREES THAT, EXCEPT AS AUTHORIZED IN WRITING BY INGERSOLL-RAND COMPANY, IT WILL (1) NOT USE THE DOCUMENT OR ANY COPY THEREOF OR THE CONFIDENTIAL OR TRADE SECRET INFORMATION THEREIN; (2) NOT COPY THE DOCUMENT; (3) NOT DISCLOSE TO OTHERS EITHER THE DOCUMENT OR THE CONFIDENTIAL OR TRADE SECRET INFORMATION THEREIN; AND (4) UPON COMPLETION OF THE NEED TO RETAIN THE DOCUMENT, OR UPON DEMAND, RETURN THE DOCUMENT, ALL COPIES THEREOF, AND ALL MATERIAL COPIED THEREFROM.		CHECKED PVS 25JUN11 APPROV DP 25JUN11 ENCL. NO. 42, 99 SCALE NTS FSCM 6R484		TITLE DIAGRAM, P&ID TOTAL SYSTEM SIZE D ENCL05161 DWG NO. 23908379 REV F		SHEET 1 OF 2	

REVISIONS					
REV	ECN	DESCRIPTION	DWN	APV	DATE
A	ENL05033	ORIGINAL RELEASE	PVS	DP	25JUN11
B	ENL05082	HOT DISCHARGE TAPPING ADDED	PVS	DP	25JUL11
C	ENL05119	REVISED AS PER CUST. COMMENTS	PVS	DP	16AUG11
D	ENL05161	REVISED AS PER CUST. COMMENTS	PVS	DP	15SEP11
E	ENL05161	REVISED AS PER CUST. COMMENTS	SRJ	GTP	21JAN12
F	0	AS-BUILT	ASH	BG	24AUG12

LINE SCHEDULE:

LINE	LINE NUMBER	MATERIAL	SCHEDULE	WALL THICKNESS
L1	AC-BAA-3-1301	CS	40	-
L2	PW-AAA-3/4-1303	SS304	-	0.065
L3	AC-BAA-3-1302	CS	40	-
L4	AC-BAA-3-1303	CS	40	-
L5	AC-BAA-4-1303	CS	40	-
L6	AC-BAA-3-1304	CS	40	-
L7	PW-BAA-1/2-1304	SS304	-	0.035
L8	AC-BAA-3-1305	CS	40	-
L9	AC-CAA-3-1307	CS	80	-
L10	AC-CAA-3-1307	CS	80	-
L14	GL-AAA-1.5-1303	SS304	-	0.065
L15	GL-AAA-3/8-1316	SS304	-	0.035
L16	GL-AAA-3/4-1310	SS304	-	0.065
L17	GL-AAA-3/4-1312	SS304	-	0.065
L18	GL-AAA-3/8-1318	SS304	-	0.035
L19	GL-AAA-3/4-1314	SS304	-	0.065
L21	GL-AAA-1.5-1300	SS304	-	0.065
L22	GL-AAA-3/8-1317	SS304	-	0.035
L23	GL-AAA-3/4-1311	SS304	-	0.065
L24	GL-AAA-3/4-1313	SS304	-	0.065
L25	GL-AAA-3/8-1319	SS304	-	0.035
L26	GL-AAA-3/4-1315	SS304	-	0.065

SEE NOTE 1

SEE NOTE 2

SEE NOTE 2

SEE NOTE 3


SEE NOTE 3

TAG NO:

PSV1	PSV-9810
TSH2	TSH-9810
PSV2	PSV-9812
CSV1	XV-9812
PSV3	PSV-9811
CSV2	XV-9813
PSV4	PSV-9814
SWV1	XV-9810
TSH1	TSH-9811
SFI-1	FG-9814
TI-1	TG-9810
TWV-1	TV-9810
SFI-2	FG-9810
TI-2	TG-9814
SFI-3	FG-9816
TI-3	TG-9811
TWV-3	TV-9811
SFI-5	FG-9811
PRV	PCV-9814
PI	PG-9814
UNL-1	XV-9814A
UNL-2	XV-9814B
YS1	SP-7100
YS2	SP-7101
YS3	SP-7102

NOTES:

1. L1 IS FITTING ON Y-9810, NOT SEPARATE SPOOL
2. L4 & L5 ARE ONE SPOOL
3. L9 & L10 ARE ONE SPOOL

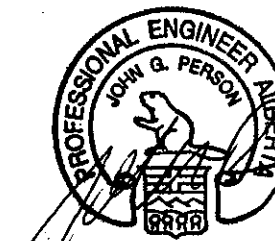

APPROVAL SCOPE
FOR PIPING ONLY

RC 20.11 23908379 P&ID REV. 5 13 1P

COPYRIGHT © 2001 INGERSOLL-RAND COMPANY ALL RIGHTS RESERVED		WARNING: THE CONTENT OR REPRODUCTION OF THIS DRAWING IS SUBJECT TO U.S. EXPORT ADMINISTRATION REGULATIONS AND OTHER APPLICABLE GOVERNMENTAL RESTRICTIONS ON REEXPORTS.		MICROFILM BLANKSHEET SCALE 0 1 2 3 4 5 6 7 8 9 10 11 12		THIS DRAWING IS THE PROPERTY OF INGERSOLL-RAND COMPANY, AND IS LOANED TO THE USER IN CONFIDENCE. THE USER SHALL NOT REPRODUCE OR TRANSMIT THIS DRAWING IN ANY FORM OR BY ANY MEANS, ELECTRONIC OR MECHANICAL, INCLUDING PHOTOCOPYING, RECORDING, OR BY ANY INFORMATION STORAGE AND RETRIEVAL SYSTEM, WITHOUT THE WRITTEN PERMISSION OF INGERSOLL-RAND COMPANY.		INGERSOLL Rand Industrial Technologies			
DRAWING CONFORMS TO ASME Y14.5M - 1994		PROPRIETARY NOTICE THIS DOCUMENT CONTAINS CONFIDENTIAL AND TRADE SECRET INFORMATION, IS THE PROPERTY OF INGERSOLL-RAND COMPANY, AND IS LOANED TO THE USER IN CONFIDENCE. THE USER SHALL NOT REPRODUCE OR TRANSMIT THIS DRAWING IN ANY FORM OR BY ANY MEANS, ELECTRONIC OR MECHANICAL, INCLUDING PHOTOCOPYING, RECORDING, OR BY ANY INFORMATION STORAGE AND RETRIEVAL SYSTEM, WITHOUT THE WRITTEN PERMISSION OF INGERSOLL-RAND COMPANY.		DATE 25JUN11		DATE 25JUN11		DATE 25JUN11		TITLE DIAGRAM, P&ID TOTAL SYSTEM	
				DATE 25JUN11		DATE 25JUN11		DATE 25JUN11		SIZE D	
				DATE 25JUN11		DATE 25JUN11		DATE 25JUN11		ECN ENL05161	
				DATE 25JUN11		DATE 25JUN11		DATE 25JUN11		DWG NO. 23908379	
				DATE 25JUN11		DATE 25JUN11		DATE 25JUN11		REV F	
				DATE 25JUN11		DATE 25JUN11		DATE 25JUN11		SHEET 2 OF 2	
				DATE 25JUN11		DATE 25JUN11		DATE 25JUN11		UNIT P&ID-7	
				DATE 25JUN11		DATE 25JUN11		DATE 25JUN11		FSCM 6R484	

[illegible]

THREE STREAMS ENGINEERING LTD.		Vendor Document Review	
Squad Check # 049	Equipment Tag # K-9810	Reviewed By <i>Em</i>	Date May 23/11
<p>Note: Fabricator is responsible for compliance with all purchase specifications. T.S.E. assumes no responsibility for compliance by approval of these documents</p>			
<p><input checked="" type="checkbox"/> APPROVED WITHOUT EXCEPTION: Proceed with fabrication & issue final dwgs.</p> <p><input type="checkbox"/> APPROVED EXCEPT AS MARKED: Proceed with fabrication & reissue dwgs.</p> <p><input type="checkbox"/> NOT APPROVED: Revise drawings as marked & reissue for approval.</p> <p><input type="checkbox"/> REVIEW NOT REQUIRED: For information only.</p>			

CCN No.	TAG No.	DESCRIPTION	MAKE	
39259254M	---	SG INTELLISYS CONTROLLER	IR SCOPE	---
39201918	RFI	RFI-FILTER		---
42412122M	X-IRI	INTELLISYS REMOTE INTERFACE [WITH POWER SUPPLY CARD]		---
70448042	PSU	POWER SUPPLY UNIT FOR 12V DC [120VAC/12VDC, RATING 5A]	PHOENIX	CSA APPROVA
68188473	TVSS	TRANSIENT VOLTAGE SUPPRESSOR	PHOENIX	CSA APPROVA
70465448	L1	120V AC CONTROL SUPPLY ON INDICATING LAMP [3PLBR]	TEKNIC	CSA APPROVA
70465455	L2	12V DC CONTROL SUPPLY ON INDICATING LAMP [3PLBR]		
70484037	B1	EMERGENCY STOP [MUSHROOM STAYPUT]		
70484029	B2	OVERLOAD RESET PUSH BUTTON	TEKNIC	CSA APPROVA
70471966	L	POWER CONTACTOR FOR STARTER [TYPE LC1F185,185A]	TELEMECANIQUE [SCHNEIDER]	CSA APPROVA
17277668	O/LR	OVERLOAD RELAY [TYPE LR9-F5369, 90-150A]		
70484011	1R-6R	AUXILIARY RELAY [MY-4N]	OMRON	CSA APPROVA
---	---	SOCKET FOR AUXILIARY RELAY [ERS14M]	ESSEN	CSA APPROVA
17283292	MCB1 & 2	MINIATURE CIRCUIT BREAKER [REMOVED]	ABB	CSA APPROVA
70469283	MCB3	MINIATURE CIRCUIT BREAKER [REMOVED]		
70469291	MCB4	MINIATURE CIRCUIT BREAKER [S201C10 1P 10A]		
17277831	XR1	STEP DOWN TRANSFORMER [REMOVED]	SHILCHAR	CSA APPROVA
1----	XR2	STEP DOWN TRANSFORMER [REMOVED]	SHILCHAR	CSA APPROVA
70465463	ATB,VB,IB,HTB,RTB	TERMINAL BLOCK [UK 2.5B, 2.5 MM SQ.]	PHOENIX	CSA APPROVA
----	----	END CONNECTOR FOR INTELLISYS [MSTB 2.5, 2/3/4WAY]		
70465505	----	RC. SCANNER	TELEMECANIQUE	CSA APPROVA

TES

UNLESS SPECIFIED OTHERWISE ALL DIMENSION ARE IN mm.
PANEL CABINET TO BE FABRICATED USING 3mm CRCA SHEET.
ALL WELDED JOINTS TO BE TACK WELDED USING ELECTRIC WELDING.
STEPS FOR PAINTING
A) CLEANING, DE-RUSTING & PHOSPHATING.
B) TWO COATS OF PRIMER.
C) APPLICATION OF FILLER ON EXTERNAL FACES FOR SURFACE FINISH.
D) TWO COATS OF FINAL PAINTS AS PER SHADE MUNSELL 3.6Y 7.31/2.9 FOR OUT SIDE ,IN SIDE & MOUNTING PLATE.
DOOR TO BE PROVIDED WITH RUBBER GASKET & GASKETING FOR INTELISYS CONTROLLER.
PANEL PROTECTION IP:65 NEMA-4 AS PER IS:2147.

COPYRIGHT© 2001
INGERSOLL-RAND COMPANY
ALL RIGHTS RESERVED

DRAWING CONFORMS TO
ASME Y14.5M - 1994

WARNING: THE EXPORT OR REEXPORT OF THIS DRAWING
OR A PRODUCT PRODUCED BY THIS DRAWING IS SUBJECT
TO U.S. EXPORT ADMINISTRATION REGULATIONS AND OTHER
APPLICABLE GOVERNMENTAL RESTRICTIONS OR REGULATIONS

PROPRIETARY NOTICE


THIS DOCUMENT CONTAINS CONFIDENTIAL AND TRADE SECRET INFORMATION, IS THE PROPERTY OF INGERSOLL-RAND COMPANY, AND IS GIVEN TO THE RECEIVER IN CONFIDENCE. THE RECEIVER BY RECEPTION AND RETENTION OF THE DOCUMENT ACCEPTS THE DOCUMENT IN CONFIDENCE AND AGREES THAT, EXCEPT AS AUTHORIZED IN WRITING BY INGERSOLL-RAND COMPANY, IT WILL:

- (1) NOT USE THE DOCUMENT OR ANY COPY THEREOF OR THE CONFIDENTIAL OR TRADE SECRET INFORMATION THEREIN;
- (2) NOT COPY THE DOCUMENT;
- (3) NOT DISCLOSE TO OTHERS EITHER THE DOCUMENT OR THE CONFIDENTIAL OR TRADE SECRET INFORMATION THEREIN; AND
- (4) UPON COMPLETION OF THE NEED TO RETAIN THE DOCUMENT, OR UPON DEMAND, RETURN THE DOCUMENT, ALL COPIES THEREOF, AND ALL MATERIAL COPIED THEREFROM.

A horizontal scale labeled "MICROFILM BLOWBACK SCALE". It has a "0" at the left end and a "1 in" at the right end. There are four major tick marks between 0 and 1, dividing the scale into five equal segments. Each segment has a smaller tick mark at its midpoint.

NOTICE

TRADE SECRET INFORMATION,
ANY, AND IS GIVEN TO THE
RECEPTION AND RETENTION OF
CONFIDENCE AND AGREES THAT,
ROLL-RAND COMPANY, IT WILL
HEREOF OR THE CONFIDENTIAL
NOT COPY THE DOCUMENT;
DOCUMENT OR THE CONFIDENTIAL
(4) UPON COMPLETION OF
N DEMAND, RETURN THE
TERIAL COPIED THEREFROM.




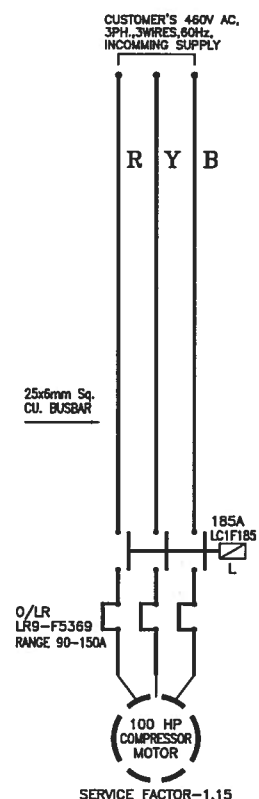
THIRD ANGLE PROJECTION

DRAWN	DATE
-------	------


JSP	23JUN11
-----	---------

CHECKED	
NPP	23JUN11
APPRVD	
KBP	23JUN11
CHG. NOS.	42, 99
SCALE	NTS
E5CM 6R484	


			
TITLE			
ELECTRIC SCHEMATIC & PANEL LAYOUT			
SIZE	ECN	DWG NO.	REV
B	ENL05403	23911597	F
WT	UNIT	PHE	SHEET 1 OF 3




MOTOR DATA	
MOTOR	100HP [FV]
FULL LOAD CURRENT	121A [W/O SF]
FULL LOAD CURRENT	150A [WITH SF]
VOLTS	460V
PHASE	3
FREQUENCY	60 Hz
SERVICE FACTOR	1.15
TYPE	SQ. CAGE

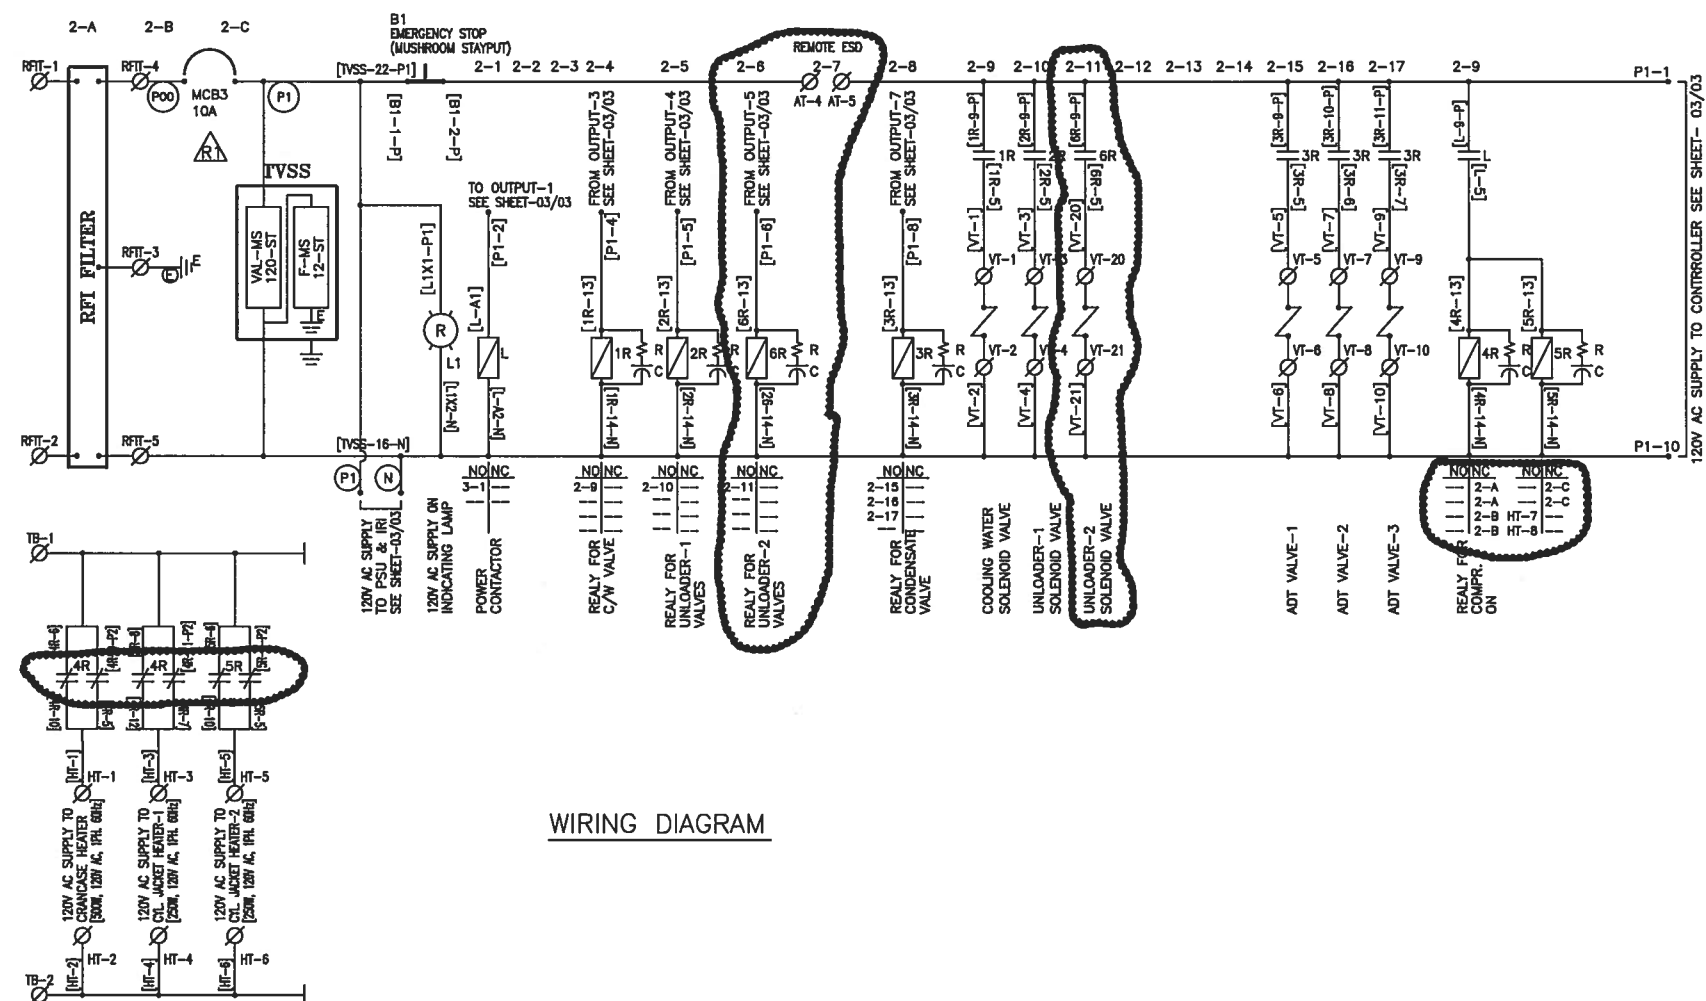


WIRING DIAGRAM

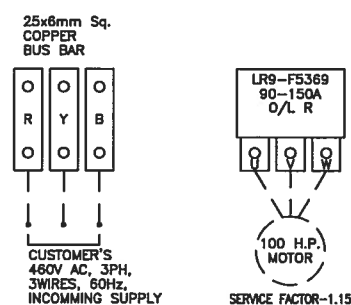


VTB TERMINAL SIZE 2.5MM SQ.

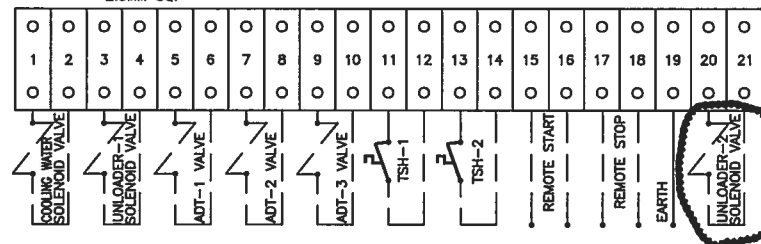


ATB TERMINAL SIZE 2.5MM SQ.

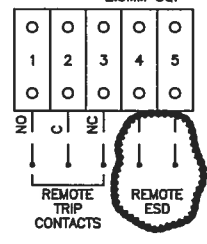


ITB TERMINAL SIZE 2.5MM SQ.

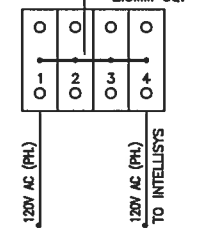


HTB TERMINAL SIZE 2.5mm?

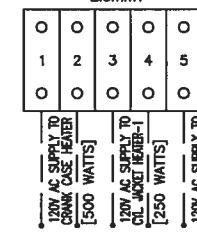

RFTB TERMINAL SIZE 2.5mm?

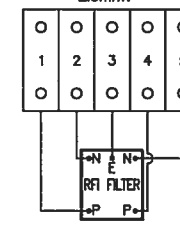

TB TERMINAL SIZE 2.5mm?

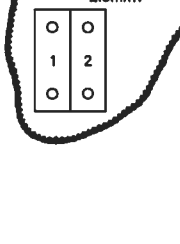


COPYRIGHT © 2001
INGERSOLL-RAND COMPANY
ALL RIGHTS RESERVED

DRAWING CONFORMS TO
ASME Y14.5M - ANSI

WARNING: THE EXPORT OR REEXPORT OF THIS DRAWING
OR A PRODUCT PRODUCED BY THIS DRAWING IS SUBJECT
TO U.S. EXPORT ADMINISTRATION REGULATIONS AND OTHER
APPLICABLE GOVERNMENTAL RESTRICTIONS OR REGULATIONS.

MICROFILM BLOWBACK
SCALE

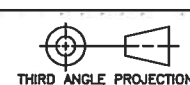

THIRD ANGLE PROJECTION

DRAWN DATE

JSP 23JUN11

CHECKED NPP 23JUN11

APPRVD KBP 23JUN11

CHG. NOS. 42, 99

SCALE NTS

FSCM 6R484

IR Ingersoll Rand
Industrial Technologies


TITLE
ELECTRICAL SCHEMATIC & PANEL LAYOUT

SIZE B ECN ENL05403 DWG NO. 23911597 REV F

WT. WT UNIT BNET SHEET 2 OF 3



3-13-2

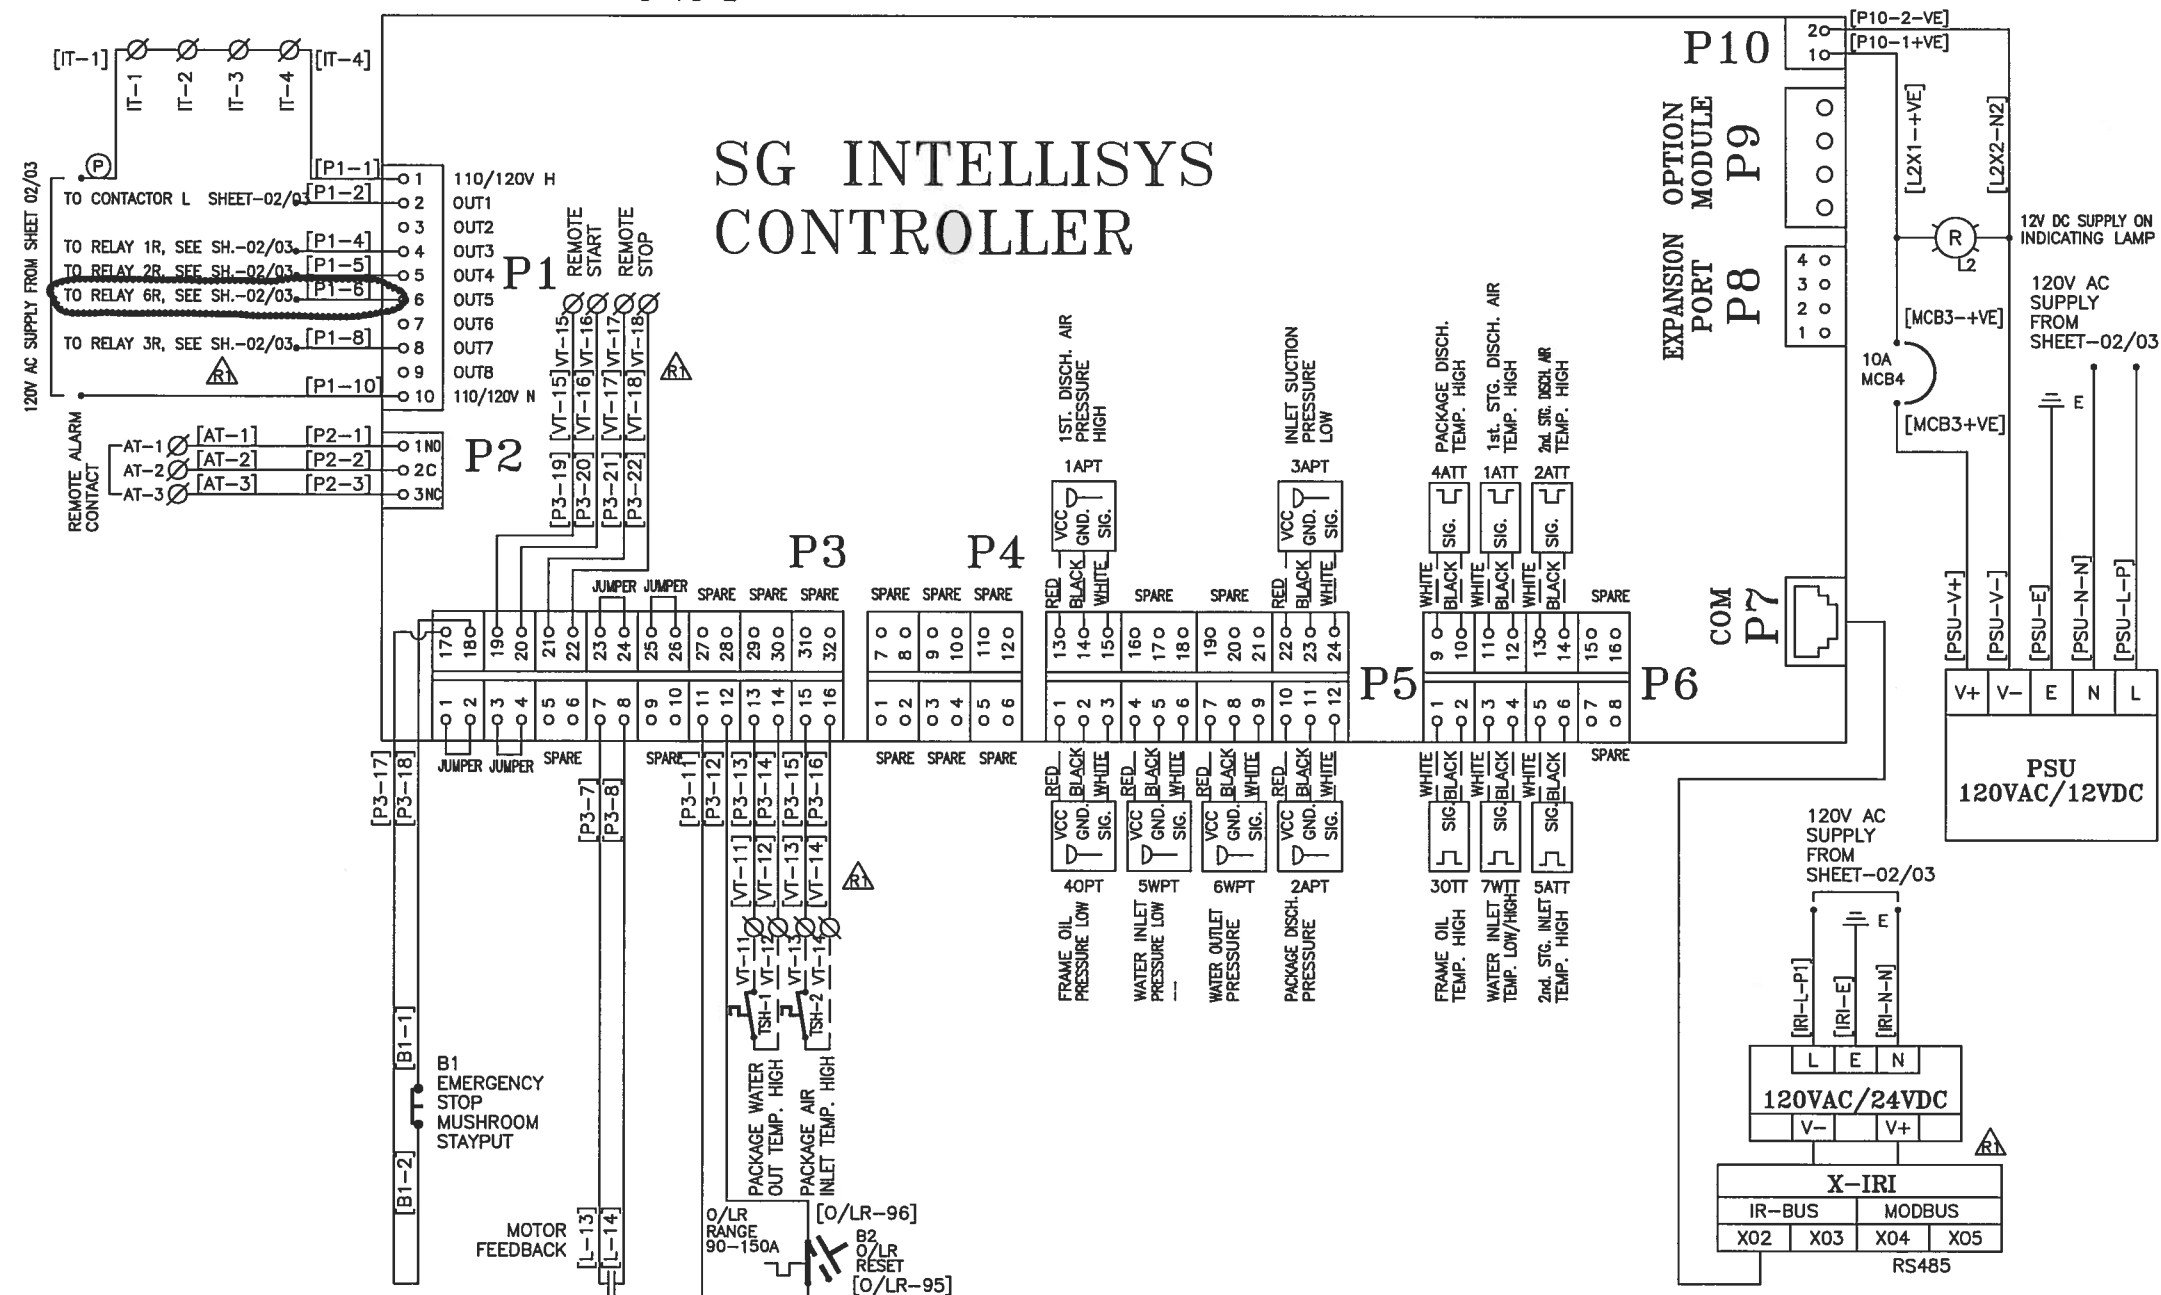

COPYRIGHT © 2001
INGERSOLL-RAND COMPANY
ALL RIGHTS RESERVED

DRAWING CONFORMS TO
ASME Y14.5M - ANSI

WARNING: THE EXPORT OR REEXPORT OF THIS DRAWING
OR A PRODUCT PRODUCED BY THIS DRAWING IS SUBJECT
TO U.S. EXPORT ADMINISTRATION REGULATIONS AND OTHER
APPLICABLE GOVERNMENTAL RESTRICTIONS OR REGULATIONS.

MICROFILM BLOWBACK
SCALE
0 1 in

PROPRIETARY NOTICE

THIS DOCUMENT CONTAINS CONFIDENTIAL AND TRADE SECRET INFORMATION,
IS THE PROPERTY OF INGERSOLL-RAND COMPANY, AND IS GIVEN TO THE
RECEIVER IN CONFIDENCE. THE RECEIVER BY RECEPTION AND RETENTION OF
THE DOCUMENT ACCEPTS THE DOCUMENT IN CONFIDENCE AND AGREES THAT,
EXCEPT AS AUTHORIZED IN WRITING BY INGERSOLL-RAND COMPANY, IT WILL
(1) NOT USE THE DOCUMENT OR ANY COPY THEREOF OR THE CONFIDENTIAL
OR TRADE SECRET INFORMATION THEREIN; (2) NOT COPY THE DOCUMENT;
(3) NOT DISCLOSE TO OTHERS EITHER THE DOCUMENT OR THE CONFIDENTIAL
OR TRADE SECRET INFORMATION THEREIN; AND (4) UPON COMPLETION OF
THE NEED TO RETAIN THE DOCUMENT, OR UPON DEMAND, RETURN THE
DOCUMENT, ALL COPIES THEREOF, AND ALL MATERIAL COPIED THEREFROM.

THIRD ANGLE PROJECTION
DRAWN JSP DATE 23JUN11
CHECKED NPP DATE 23JUN11
APPRVD KBP DATE 23JUN11
CHG. NOS. 42, 99
SCALE NTS
FSCM 6R484

IR Ingersoll Rand
Industrial Technologies

TITLE
ELECTRICAL SCHEMATIC & PANEL LAYOUT

SIZE B	ECN ENL05403	DWG NO. 23911597	REV F
WT.	UNIT PHE	SHEET 3 OF 3	

Tag K-9810

Ingersoll-Rand Order No. 10832269 / 80718328																
INGERSOLL-RAND MODEL5 & 4 X 7 PHE7 COMPRESSOR INSTRUMENT LIST																
Ingersoll-Rand P&ID drawing no. 23908379																
Cenovus Inst Tag #	Instrument Tag P & ID	CCN	Function	Normal		Warning Not Advjustable	Warning		Trip	Trip		Type	Range	Manufacturer	Model #	Controller I/O Signal
				Pressure (psig)	Temp. (F)		L	H		LL	HH					
PT-9816	1APT	54364104IM	1st stage discharge air pressure	263.087	241.660	95 % of trip set point	-	269.92 psig	8 % higher of Operating Pressure	-	284.12 psig	Pressure Transmitter	150-500 PSI	Texas Instruments,Kevlico	NA	AI
TE/TT-9816	1ATT	39571310IM	1st stage discharge air Temperature	263.087	241.660	97 % of trip set point	-	263.5 Deg F	Operating Temperature + 30 Deg F	-	271.66 Deg F	Temperature Transmitter	(-)58-758 F	Temp-Pro	NA	AI
PT-9811	2APT	54364096IM	Package discharge air pressure (off-Design)	900.000	119.000	95% of trip value	-	923.00 psig	8% Higher of Operating	-	972.00 psig	Pressure Transmitter	0-1000 PSI	Texas Instruments,Kevlico	NA	AI
TE/TT-9811	2ATT	39571310IM	2nd stage discharge air Temperature	869.300	361.320	97 % of trip set point	-	379.27 Deg C	Operating Temperature + 30 Deg F	-	391.20 Deg F	Temperature Transmitter	(-)58-758 F	Temp-Pro	NA	AI
PT-9810	3APT	39875539	Suction Pressure	115.000	104.000	105 % if Low trip set point-Not adjustable, 95 % of High trip Value	106.05 psig	119.2 psig	10 % Lower /10% Higher of Operating Pressure	101 psig	125.48 psig	Pressure Transmitter	0-225 PSI	Kavlico Corporation	P4050-5130	AI
TE/TT-9819	3OTT	39571310IM	Frame Oil Temperature	-	-	95 % of trip Value	-	165 Deg F	Fixed	-	175 Deg F	Temperature Transmitter	(-)58-758 F	Temp-Pro	NA	AI
PT-9819	4OPT	39875539	Frame Oil Pressure	-	-	120 % of trip set point	7.5 psig	-	Fixed	6 psig	-	Pressure Transmitter	0-225 PSI	Kavlico Corporation	P4050-5130	AI
TE/TT-9817	4ATT	39571310IM	Package discharge air Temperature (NOTE 1)	869.300	119.000	97 % of trip Value	-	144.53 Deg F	Operating Temperature + 30 Deg F	-	149 Deg F	Temperature Transmitter	(-)58-758 F	Temp-Pro	NA	AI
TT-9812	SATT	39571310IM	2nd stage inlet air Temperature	257.531	119.000	97 % of trip Value	-	144.53 Deg F	Operating Temperature + 30 Deg F	-	149 Deg F	Temperature Transmitter	(-)58-758 F	Temp-Pro	NA	AI
PT-9818A	5WPT	39875539	Package Inlet Glycol/Water pressure	45.000	40-107	97 % of trip Value, 5% lower of Operating Value	38 psig	47.5 Deg F	8% Higher of Operatign Pressure	-	67.5 psig	Pressure Transmitter	0-225 PSI	Kavlico Corporation	P4050-5130	AI
PT-9818A	5WPT	39875539	Package Inlet Glycol/Water pressure	45.000	40-107	-	-	-	10 % Lower of Operating Value	40 psig	-	Pressure Transmitter	0-225 PSI	Kavlico Corporation	P4050-5130	AI
PT-9818B	6WPT	39875539	Package Outlet Glycol /Water pressure (use for low pressure drop)	35.000	125.000	5% lower of Operating Value	33.25 psig	-	10 % Lower of Operating Value	20 psig	-	Pressure Transmitter	0-225 PSI	Kavlico Corporation	P4050-5130	AI
TE/TT-9805	7WTT	39571310IM	Package Inlet Glycol/Water Temperature	45.000	40-107	5 % of Operating Vaule	38 Deg F	-	20 % of Operating value	36 Deg F	-	Temperature Transmitter	(-)58-758 F	Temp-Pro	NA	AI
TE/TT-9805	7WTT	39571310IM	Package Inlet Glycol/Water Temperature	45.000	40-107	97 % of trip Value	-	144 Deg F	10 % of Operating Value	-	117.7 Deg F	Temperature Transmitter	(-)58-758 F	Temp-Pro	NA	AI
TSHH-9818	TSH-1	39198494IM	Package Outlet Glycol/Water Temperature	35.000	125.000	-	-	-	10% of Operating Temp.	-	137.5 Deg F	Temperature Switch	50-650 F	United Electric	F6G-12146 WITH 3BC-6F28 MODIFICATION	DI
TSHH-9810	TSH-2	39198494IM	Package Air Inlet Temperature	114.080	104.000	-	-	-	5% of Operating Value	-	109.2 Drg F	Temperature Switch	50-650 F	United Electric	F6G-12146 WITH 3BC-6F28 MODIFICATION	DI
PSV-9810	PSV1	39323688IM	Suction volume bottle Safety Valve	-	-	-	-	-	-	-	139 PSIG	Safety Valve	E Orifice	Farris	27EA34-M40/00	N/A
PSV-9812	PSV2	17343302	1st stg discharge Safety valve	-	-	-	-	-	-	-	300 PSIG	Safety Valve	D Orifice	Farris	27DA33-M40/00	N/A
PSV-9811	PSV3	23913403	Discharge Volume Bottle safety Valve (off-Design)	-	-	-	-	-	-	-	1100 PSIG	Safety Valve	N/A	Kunkle	0189-C01-KH	N/A
PSV-9814	PSV4	39331368IM	Regulation Safety valve	-	-	-	-	-	-	-	90 PSIG	Safety Valve	N/A	Kingston	118CSS-5-090	N/A
XV-9812	CSV1	39309034	Interstage Separator Drain	-	-	Open for 2 seconds in Every 3 minutes.	-	-	Orifice size : 3/64"	-	-	Condensate Solenoid Valve	N/A	Automatic Switch Company	8262G80	DO
XV-9813	CSV2	40057424IM	Discharge Separator Drain	-	-	Open for 2 seconds in Every 3 minutes (NOTE 2)	-	-	Orifice size : 5/16"	-	-	Condensate Solenoid Valve	N/A	Automatic Switch Company	8262G27	DO
XV-9810	SWV1	39111877IM	Cooling Glycol /Water Inlet (NOTE 3)	-	-	-	-	-	--	-	-	Solenoid Water Valve	N/A	ASCO	A821OG22	DO
TCV-9810	TMV-1	54635701IM	LP cylinder Glycol /water Outlet	-	-	Set @ 120 Deg F.	-	-	Not Adjustable	-	-	Thermostatic Water Control Valve	N/A	FLUID POWER ENERGY	A1111GKVV3-120	--
TCV-9816	TMV-2	54635693IM	Intercooler Glycol /Water Outlet	-	-	Set @ 100 Deg F.	-	-	Not Adjustable	-	-	Thermostatic Water Control Valve	N/A	FLUID POWER ENERGY	A1111GKVV3-100	--
TCV-9811	TMV-3	54635701IM	HP Cylinder Glycol /Water Outlet	-	-	Set @ 120 Deg F.	-	-	Not Adjustable	-	-	Thermostatic Water Control Valve	N/A	FLUID POWER ENERGY	A1111GKVV3-120	--
TCV-9817	TMV-4	54635693IM	Aftercooler Glycol /Water Outlet	-	-	Set @ 100 Deg F (NOTE 2)	-	-	Not Adjustable	-	-	Thermostatic Water Control Valve	N/A	FLUID POWER ENERGY	A1111GKVV3-100	--
XV-9814A	UNL1	54635693IM	Capacity Load/Unload	-	-	-	-	-	--	-	-	0% Solenoid Unloader Valve	N/A	Automatic Switch Company	8262G16	DO
XV-9814B	UNL2	54635693IM	Capacity Load/Unload	-	-	-	-	-	--	-	-	50% Solenoid Unloader Valve	N/A	Automatic Switch Company	8262G16	DO
PCV-9814	PRV	39322549IM	Regulation System Pressure Regulating Valve	-	-	-	-	-	Control Orifice:3/16"	-	-	Pressure Regulator	N/A	Grove' Mity-Mite'	# 94-11486P2A	-
PG-9414	PI	39322763	Regulation System Pressure	-	-	-	-	-	-	-	-	Pressure Gauge	0-110 Psi-g	Asohr'oft	25-1009AWL-02L-0/110 MG	-
TG-9810	TI-1	40048423	LP Cylinder Glycol/Water Outlet	-	-	-	-	-	-	-	-	Dial Type Thermometer	0-250 Deg F	-	-	-
TG-9816	TI-2	40048423	Irtercooler Glycol/Water Outlet	-	-	-	-	-	-	-	-	Dial Type Thermometer	0-250 Deg F	-	-	-
TG-9811	TI-3	40048423	HP Cylinder Glycol/Water Gullet	-	-	-	-	-	-	-	-	DialType Thermometer	0-250 Deg F	-	-	-
TG-9817	TI-4	40043423	Aftercooler Glycol/Water Outlet	-	-	-	-	-	-	-	-	DialType Thermometer	0-250 Deg F	-	-	-
FG-9814	SFI-1	95955464	Site Flow Indication for Water Glycol	-	-	-	-	-	Orifice:3/4"	-	-	Mechanical Sight Flow Indicator	-	-	-	-
FG-9810	SFI-2	95587895	Site Flow Indication for Water Glycol	-	-	-	-	-	Orifice:3/8"	-	-	Mechanical Sight Flow Indicator	-	-	-	-
FG-9816	SFI-3	95587895	Site Flow Indication for Water Glycol	-	-	-	-	-	Orifice:3/8"	-	-	Mechanical Sight Flow Indicator	-	-	-	-
FG-9812	SFI-4	95955464	Site Flow Indication for Water Glycol	-	-	-	-	-	Orifice: 3/4"	-	-	Mechanical Sight Flow Indicator	-	-	-	-
FG-9811	SFI-5	95507895	Site Flow Indication for Water Glycol	-	-	-	-	-	Orifice: 3/4"	-	-	Mechanical Sight Flew Indicator	-	-	-	-

NOTE :
1. TE/TT9817 (4ATT) is for provision for after cooler and currently will be programmed as read only.
2. Item Not installed.Provision for Aftercooler.
3. This Solenoid is Disabled and remains open.

Cenovus Rise Rate

PHN7904 Cooling Calculations

"Design Condition"

898 psia	Design Discharge Pressure		100% Load
Total Compressor Heatload:		(201860 btu/hr)	
Heatload Considered for 60/40 EG/H2O:		(222046 btu/hr)	
Corrected Coolant Flow in GPM:		(54.2168 gpm)	
Inlet Air Temp F	Coolant Temp F		Cooling Water Rise F
104	104		10
Stage 1	54,063.00	10.8	Stage 1 Cooler H2O gpm
Stage 2	106,297.00	21.3	Stage 2 Cooler H2O gpm
Cylinder 1	14,500.00	2.9	Stage 1 Cylinder H2O gpm
Cylinder 2	27,000.00	5.4	Stage 2 Cylinder H2O gpm
Combined BTU	201,860.00	40.4	Combined H2O GPM
**Safety Factor	1.10	1.342	Factor for 60/40 EG/H2O
Total System Heatload	222,046.00	54.22	Total GPM

"Off-Design Condition"

914 psia	Off-Design Pressure		51% Load
Total Compressor Heatload:		(204302 btu/hr)	
Heatload Considered for 60/40 EG/H2O:		(224732.2 btu/hr)	
Corrected Coolant Flow in GPM:		(54.8878 gpm)	
Inlet Air Temp F	Coolant Temp F		Cooling Water Rise F
104	104		10
Stage 1	54,479.00	10.9	Stage 1 Cooler H2O gpm
Stage 2	107,323.00	21.5	Stage 2 Cooler H2O gpm
Cylinder 1	15,000.00	3	Stage 1 Cylinder H2O gpm
Cylinder 2	27,500.00	5.5	Stage 2 Cylinder H2O gpm
Combined BTU	204,302.00	40.9	Combined H2O GPM
**Safety Factor	1.10	1.342	Factor for 60/40 EG/H2O
Total System Heatload	224,732.20	54.89	Total GPM

** Factory Safety Factor built into performance file heatload in anticipation unknown of field conditions



5 & 4 x 7 PHE7 BOL

(5 & 4 x 7 PHE7 BOL)

RECIPSelect

1.5 / 2010.008

File No.	PHN7904	Proposal No.	60/40 (TEG/H2O)	Date	08 Dec 2011
Customer	Cenovus Rise Rate	User	Ingersoll-Rand	Build ID	5051
Gas Service		Air Lubricated		Reference Conditions	
Atmospheric Pressure	psia	13.780		Pressure	psia 14.700
Atmospheric Temperature	°F	89.60		Temperature	°F 60.00
Inlet Pressure	psia	128.780		Relative Humidity	% 0.0
Inlet Temperature	°F	104.00		Stroke	in 7.000
Relative Humidity	%	100.0		Speed	rpm 376
Coolant Temperature	°F	104.00		Friction Loss	hp 4.01
Stage Data					
Compressor Data		1	2	3	4
Cylinder Diameters	in	5.0000	4.0000		
Number of Cylinders		1	1		
Valve Speed	ft/min	1365	1940		
OE Rod Diameter	in	0.0000	0.0000		
FE Rod Diameter	in	1.5000	1.5000		
Piston Area - OE	in ²	19.63	12.57		
Piston Area - FE	in ²	17.87	10.80		
Displacement OE	cfm	29.91	19.14		
Displacement FE	cfm	27.22	16.45		
Total Displacement	cfm	57.12	35.59		
OE Clearance	%	15.30	21.10		
FE Clearance	%	16.60	19.00		
Average Clearance	%	15.92	20.13		
Rod Load Compression	lb	-3099	-8567		
Rod Load Tension	lb	2432	6518		
Stage Inlet					
Stage Inlet Pressure	psia	128.780	270.740		
Stage Inlet Temperature	°F	104.00	119.00		
Compressibility Factor		0.9996	0.9966		
Total Inlet Capacity	icfm	47.51	23.08		
Capacity at Ref. Conditions	scfm	381.41	381.41		
Stage Discharge					
Stage Discharge Pressure	psia	276.266	916.327		
Stage Discharge Temp	°F	240.37	358.48		
Discharge Compressibility		1.0037	1.0269		
Compression Ratio		2.1453	3.3845		
K value of Gas		1.3964	1.3967		
Volume Exponent		1.4069	1.4464		
Volumetric Efficiency Losses	%	5.36	8.51		
Volumetric Efficiency - OE	%	83.62	63.57		
Volumetric Efficiency - FE	%	82.68	66.35		
OE Indicated Power	hp	13.44	24.66		
FE Indicated Power	hp	12.10	22.02		
Stage Power (w/Friction)	hp	29.38	54.09		
Cooler Performance					
Cooler Pressure Drop	%	2.00	2.00		
CTD	°F	15.00	15.00		
Condensation	lb/min	0.0406	0.0786		
Cooler Heat Load	Btu/hr	54063	106297		
Cooler Water Flow	gpm	10.8	21.3		
Cooler Water Temp Rise	°F	10.00	10.00		
Cylinder Water Flow	gpm	2.9	5.4		
Cylinder Water Temp Rise	°F	10.00	10.00		
Summary					
Total Capacity	scfm	381.41 (+/-) 5.0%	Discharge Pressure	psia	898.00
Compressor Shaft Power	hp	83.47	Discharge Temperature	°F	119.00
Specific Power	hp/100 scfm	21.88 (+/-) 6.0%			



5 & 4 x 7 PHE7 BOL

(5 & 4 x 7 PHE7 BOL)

RECIPSelect

1.5 / 2010.008

File No.	PHN7904	Proposal No.	60/40 (TEG/H2O)	Date	08 Dec 2011
Customer	Cenovus Rise Rate	User	Ingersoll-Rand	Build ID	5051
Gas Service		Air Lubricated		Reference Conditions	
Atmospheric Pressure	psia	13.780		Pressure	psia 14.700
Atmospheric Temperature	°F	89.60		Temperature	°F 60.00
Inlet Pressure	psia	128.780		Relative Humidity	% 0.0
Inlet Temperature	°F	104.00		Stroke	in 7.000
Relative Humidity	%	100.0		Speed	rpm 376
Coolant Temperature	°F	104.00		Friction Loss	hp 4.01

Stage Data					
Compressor Data		1	2	3	4
Cylinder Diameters	in	5.0000	4.0000		
Number of Cylinders		1	1		
Valve Speed	ft/min	1365	1940		
OE Rod Diameter	in	0.0000	0.0000		
FE Rod Diameter	in	1.5000	1.5000		
Piston Area - OE	in ²	19.63	12.57		
Piston Area - FE	in ²	17.87	10.80		
Displacement OE	cfm	29.91	19.14		
Displacement FE	cfm	27.22	16.45		
Total Displacement	cfm	57.12	35.59		
OE Clearance	%	15.30	21.10		
FE Clearance	%	16.60	19.00		
Average Clearance	%	15.92	20.13		
Rod Load Compression	lb	-3129	-8756		
Rod Load Tension	lb	2459	6675		
Stage Inlet					
Stage Inlet Pressure	psia	128.780	272.231		
Stage Inlet Temperature	°F	104.00	119.00		
Compressibility Factor		0.9996	0.9966		
Total Inlet Capacity	icfm	47.44	22.92		
Capacity at Ref. Conditions	scfm	380.81	380.81		
Stage Discharge					
Stage Discharge Pressure	psia	277.787	932.653		
Stage Discharge Temp	°F	241.46	361.32		
Discharge Compressibility		1.0038	1.0272		
Compression Ratio		2.1571	3.4260		
K value of Gas		1.3964	1.3967		
Volume Exponent		1.4069	1.4464		
Volumetric Efficiency Losses	%	5.38	8.58		
Volumetric Efficiency - OE	%	83.49	63.09		
Volumetric Efficiency - FE	%	82.55	65.91		
OE Indicated Power	hp	13.52	24.94		
FE Indicated Power	hp	12.17	22.29		
Stage Power (w/Friction)	hp	29.56	54.73		
Cooler Performance					
Cooler Pressure Drop	%	2.00	2.00		
CTD	°F	15.00	15.00		
Condensation	lb/min	0.0411	0.0784		
Cooler Heat Load	Btu/hr	54479	107323		
Cooler Water Flow	gpm	10.9	21.5		
Cooler Water Temp Rise	°F	10.00	10.00		
Cylinder Water Flow	gpm	3.0	5.5		
Cylinder Water Temp Rise	°F	10.00	10.00		

Summary					
Total Capacity	scfm	380.81 (+/-) 5.0%	Discharge Pressure	psia	914.00
Compressor Shaft Power	hp	84.29	Discharge Temperature	°F	119.00
Specific Power	hp/100 scfm	22.13 (+/-) 6.0%			