347'-0"
168'-4"
10'-4"
168'-4"

18-PERSON DORM

FUTURE
~~18~~-PERSON DORM

34 Jack + Jill Rooms

18-PERSON DORM

18-PERSON DORM

PROVIDE SET OF VALLEY TRUSSES OVER EXISTING ROOF FRAMING

NEW 18-PERSON DORM ADDITION

PROVIDE SET OF VALLEY TRUSSES

11-UNIT KITCHEN DINER RECREATION COMPLEX

195'-8"
140'-6"
55'-2"
30'-2"
25'-0"
30'-2"
25'-0"
30'-2"
25'-0"
30'-2"
35'-2"
17'-2"
60'-0"
43'-0"
60'-0"

ROOF TRUSS SPECIFICATION:
2/12 SLOPE ENGINEERED ROOF TRUSS
24" O.C. SPACING
16½" TRUSS OVERHANG [18" TOTAL]

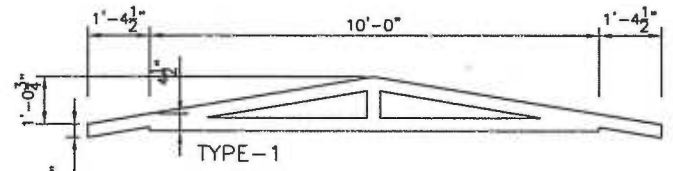

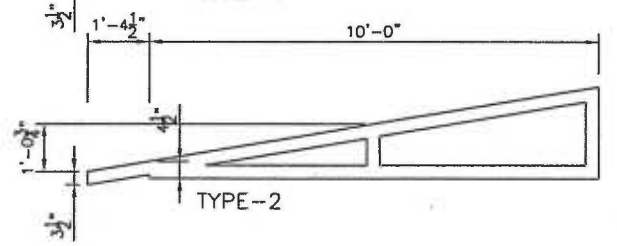

NOTES:
1. ROOF TRUSS REFERENCE=RONA TIMBER-TECH ORDER#51271 26SEP05
2. DESIGN SNOW LOAD TO JACKFISH, ALBERTA
3. ROOF TRUSSES TO MATCH EXISTING COMPLEX AS NOTED

106 Rooms Total.

REV	DATE	DESCRIPTION	BY	CHK	APP
0	19MAR07	ISSUE FOR SITE & ROOF TRUSS FRAMING REQUISITION	EM		

NOTES:

CUSTOMER ACCEPTANCE
☑ - ACCEPTANCE AS DRAWN
☐ - ACCEPTANCE EXCEPT AS NOTED
BY: Paulht
DATE: 20 Mar 07

© COPYRIGHT 2000
ALL RIGHTS RESERVED
APPEGA Permit to Practice #02312

DRAWN BY:	EM
DATE:	19MAR07
SCALE:	1"=24'-0"
CHECKED BY:	DATE:
APPROVED BY:	DATE:

CLIENT:
DEVON CANADA
10x60 ARCTIC CORRIDOR ADDITION
JACKFISH PROJECT

PROJECT:
1-10x60 UNIT ARCTIC CORRIDOR

INTERNAL DOCUMENT CONTROL
PLANT REDLINES BY: DATE:
REDLINE REC'D BY ENG BY: DATE:
DRAWING TITLE:
PROJECT SITE PLAN
COMPLEX TRUSS ROOF OUT-LINE
DRAWING NO: B-950000076-1-SP01
REVISION: 0

ATCO Structures