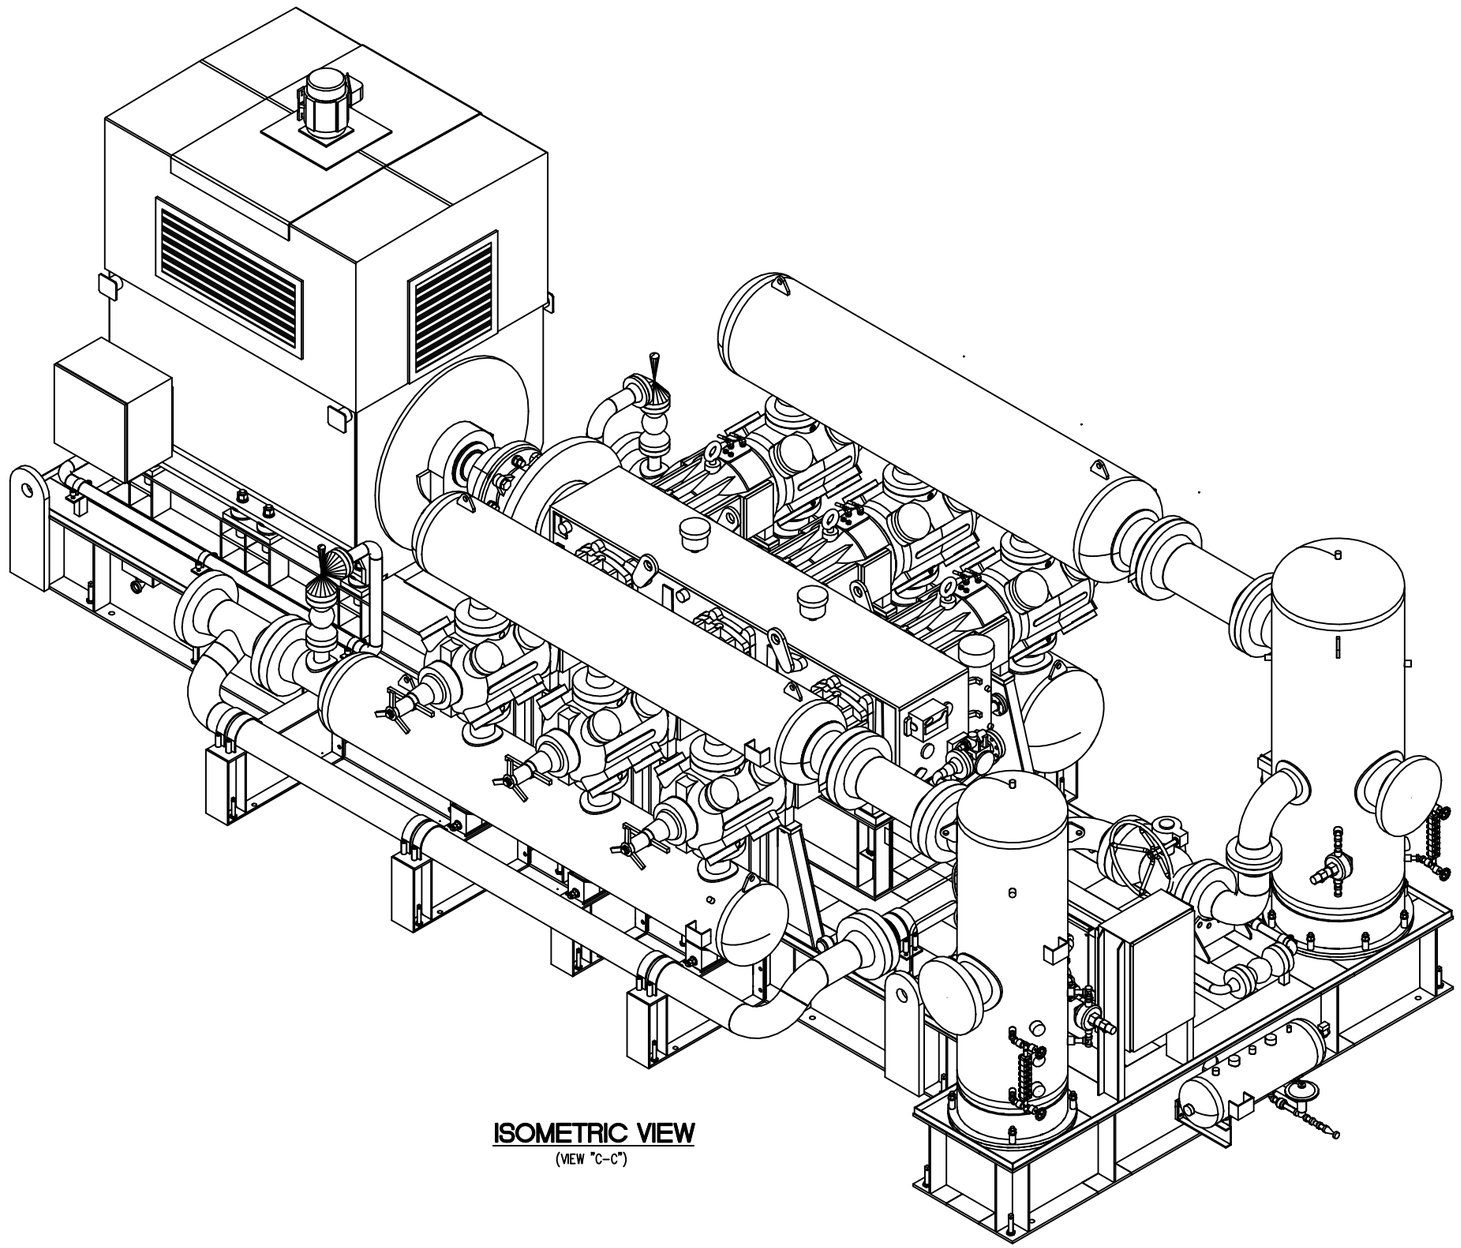

ISOMETRIC VIEW

(VIEW "C-C")

DESCRIPTION:
GENERAL ASSEMBLY
ARIEL JGC6 W/ 5000HP MOTOR

A G EQUIPMENT PROJECT:
11379-381

REVISIONS

NO	DATE	DESCRIPTION	BY
05	05/08/2012	ADDED SCRUBBER 2" NPT SIGN GLASS CONN.	LN
06	06/12/2012	AS BUILT	LN

REVISIONS

NO	DATE	DESCRIPTION	BY
00	02/03/2012	FOR CUSTOMER REVIEW/ PULSATION STUDY	LN
01	02/20/2012	PER PULSATION STUDY	LN
02	03/02/2012	PER ENGINEER	LN
03	04/17/2012	REVISED DRAIN SUMPS AND PUMP	LN
04	05/01/2012	MECHANICAL STUDY/REL. FOR FAB.	LN

	NAME	DATE
DRAWN BY	LN	02/03/2012
CHECKED BY	JAL	02/03/2012
PROJECT ENG.	JAL	02/03/2012
APPROVED BY		
CERTIFIED BY		

AG Equipment Co.
BROKEN ARROW, OKLA. 74012 • PHONE 918-250-7386 • FAX 918-250-7393

SCALE: 1/2"=1'-0"
CUSTOMER P.O. NO.: 210150-DW222
SHEET: 4 OF 4
CUSTOMER: CAIMAN ENERGY, LLC
PROJECT: FORT BEELER PLANT REJECTION
DRAWING NUMBER: 11379-A1C
ISSUE: 06

NOTICE: THIS DOCUMENT CONTAINS PROPRIETARY INFORMATION AND IT SHALL NOT BE USED OR REPRODUCED OR ITS CONTENTS DISCLOSED, IN WHOLE OR IN PART, WITHOUT THE PRIOR WRITTEN CONSENT OF A G EQUIPMENT CO.