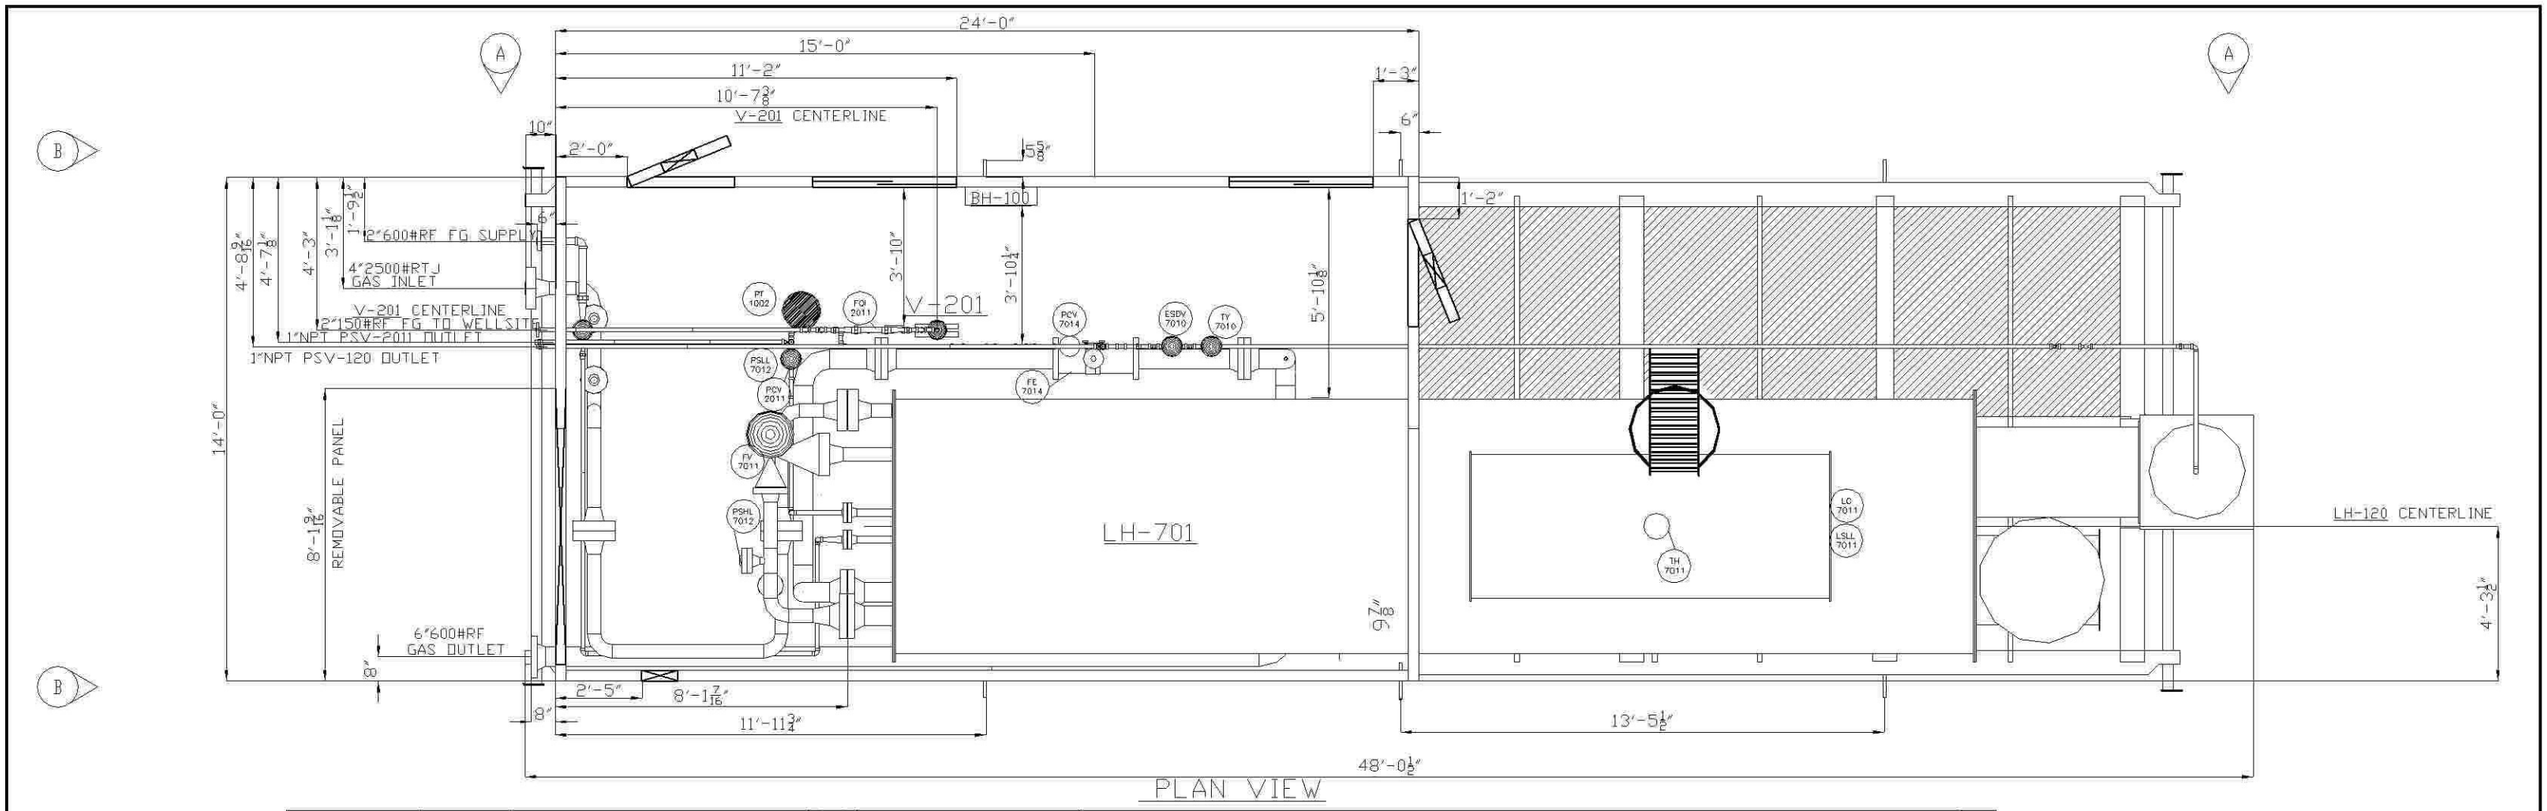

PLAN VIEW

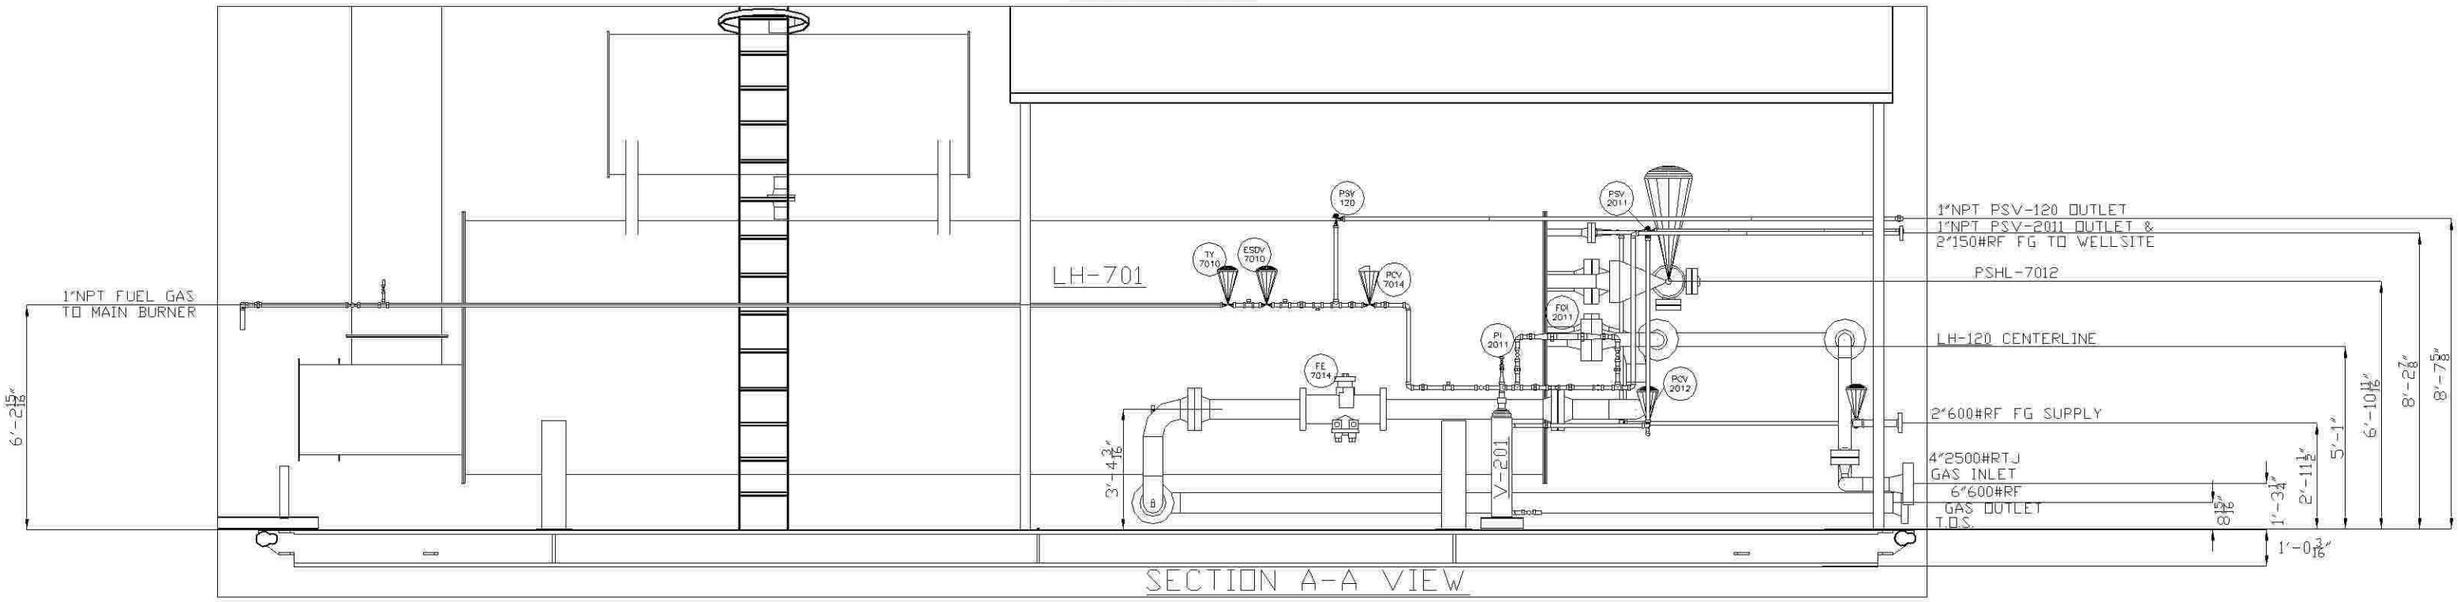

SECTION A-A VIEW

ENGINEERS & PERMIT STAMPS

AS BUILT

Chasten

NO.	REVISIONS	DWN	APPR	DATE
3	AS BUILT	AL		07-06-14
2	REV AS PER BURNER	CMP		07-04-15
1	REV LADDER AND VENT LOCATION PER MARK-UPS	CP		07-03-05
0	REV METER LENGTH-ISSUED FOR CONST.	CP		07-02-14
B	REVISED PER CUSTOMER MARK-UPS	CP		07-02-01
A	ISSUED FOR APPROVAL	CP		07-01-04

Paintearth ENERGY SERVICES INC.

DATE: 07-01-04
DESIGNED BY: PES
DRAWN BY: C.PRICHARD
CHECKED BY:
APPROVED BY:
SCALE: N.T.S.

CLIENT: BURLINGTON RESOURCES c/o SPEC ENGINEERING INC.
LSD: 04-34-52-26 W5M

TITLE: 3.75 MM BTU LINEHEATER c/w 24'-0" LONG x 14'-0" WIDE BUILDING

PROJECT NO: 6119-001
FILENAME: 6119-001GAISD
REFERENCE NO:
SHEET NO: 1 OF 2
DRAWING NO: PES-6119-001GAISD
REV. NO: 3