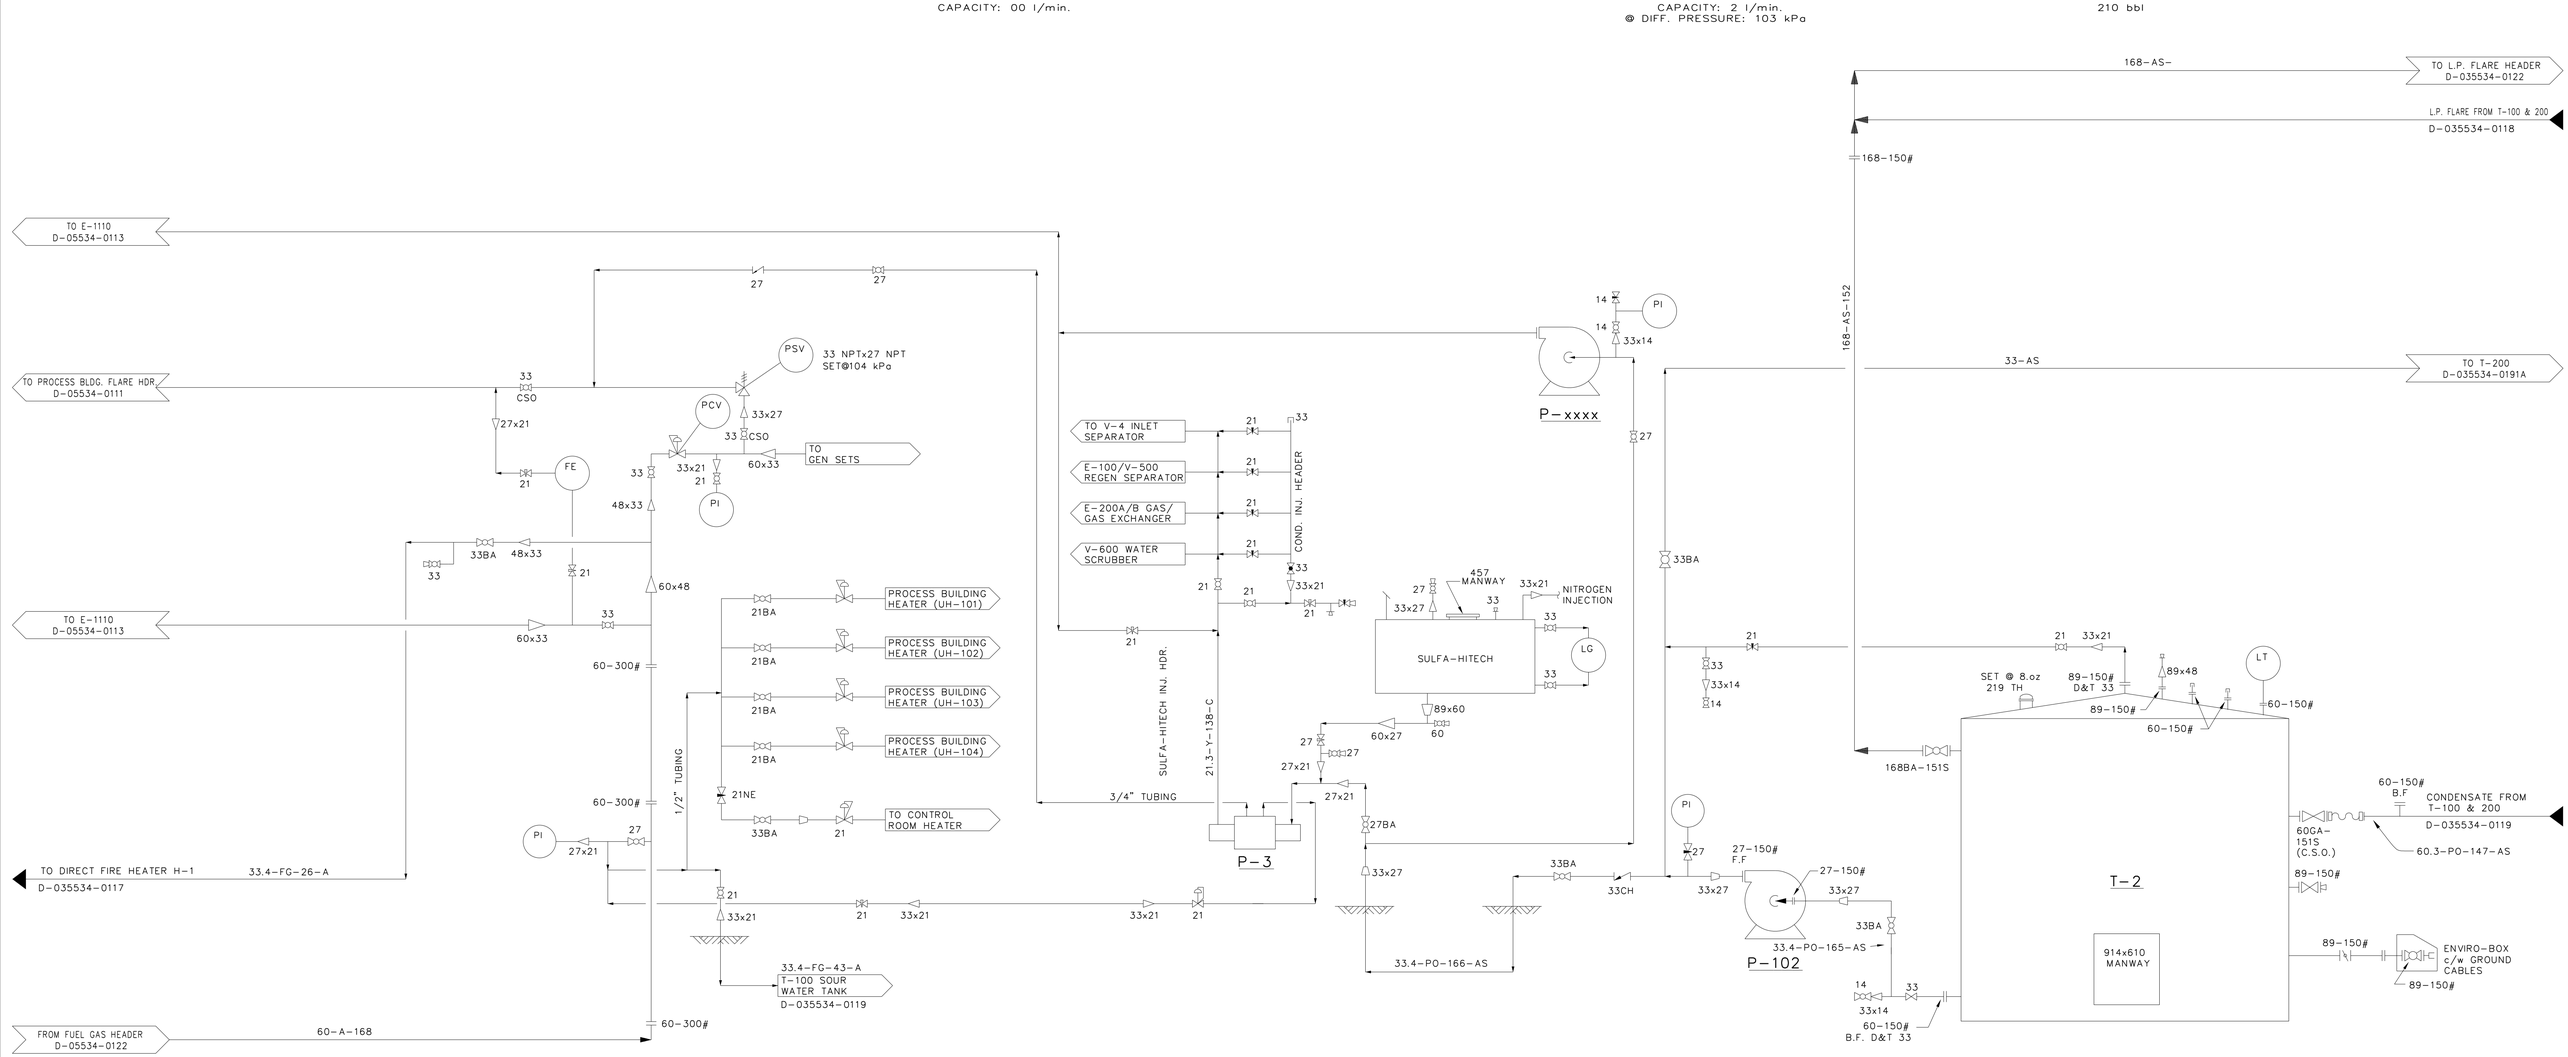

DWG. NO.	REFERENCE DRAWINGS	DEVON PROJECT	REV	REVISIONS	DATE	BY	CHK'D	APP'D	OWNR APP'D
		056677	0	AS-BUILTS BY GLE (2005) (GLE JOB #05031)	05-04-29	JSG	JLM		
		02030	B	AS BUILTS	03-10-15	CSL	BP		
		035534	A	ISSUED FOR INFORMATION	03-06-05	DMM			

ENGINEER AND PERMIT STAMPS

DESIGNED		
DRAWN	DMM	03-06-05
CHECKED		
PROCESS CK.		
MECH. CK.		
STRUCT. CK.		
ELECT. CK.		
OWNER APP.		
OWNER APP.		

GAS LIQUIDS ENGINEERING LTD.
• GAS PURIFICATION • REFRIGERATION • DISTILLATION • LIQUIDS TREATING • FACILITIES ENGINEERING

XREF: 035534-PID1.DWG
PLOTTED: SEP 19, 2005 11:49 AM

CADD FILE: Q:\02030\035534-0118.DWG

devon

NORTH COLEMAN
COMPRESSOR STATION
P & ID – CONDENSATE TANK
LSD. 04-13-09-04 W5M.

CONTR JOB NO	SCALE	DWG. NO.	DEVON PROJ.	
02030	NONE	D-035534-0118.DWG	035534	0

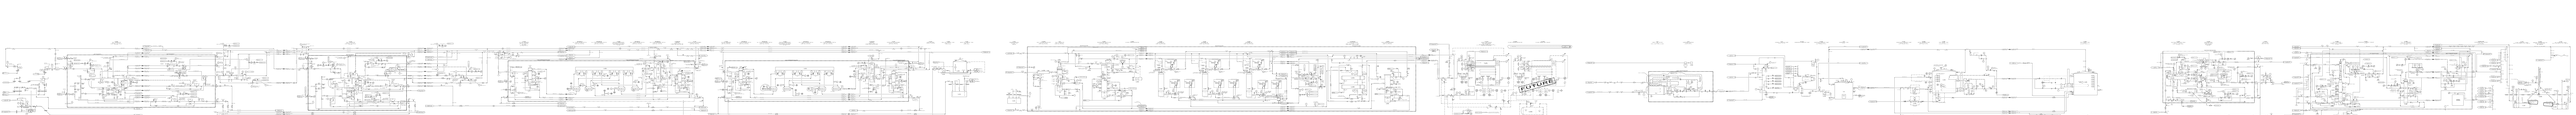
FUTURE