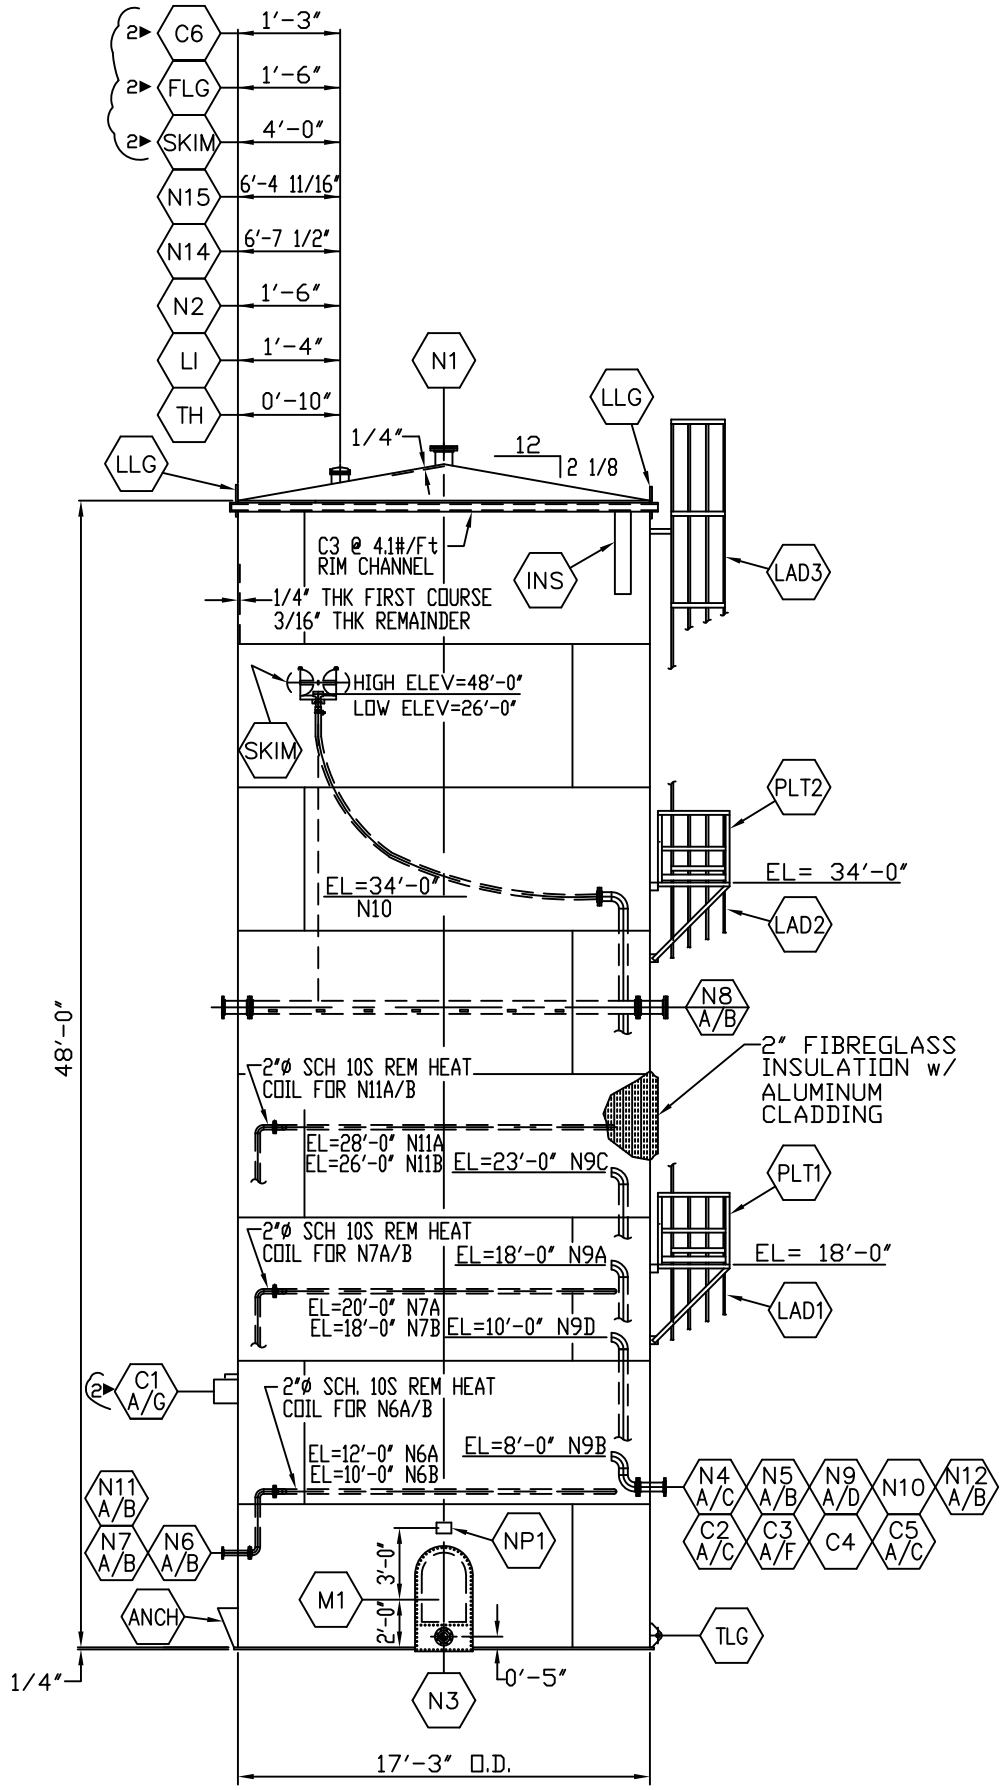

ELEVATION

(REFER TO DWG. #J-99-088-1-1 FOR TANK DATA)
(REFER TO DWG. #J-99-088-1-2a & -2b FOR NOZZLE SCHEDULE)

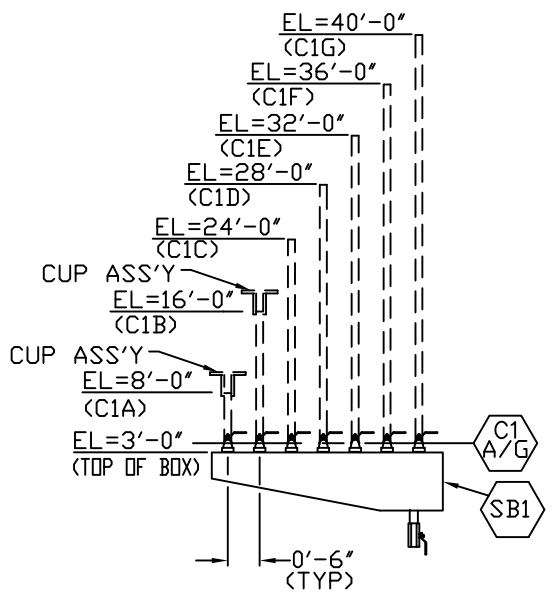

C1A/G DETAIL

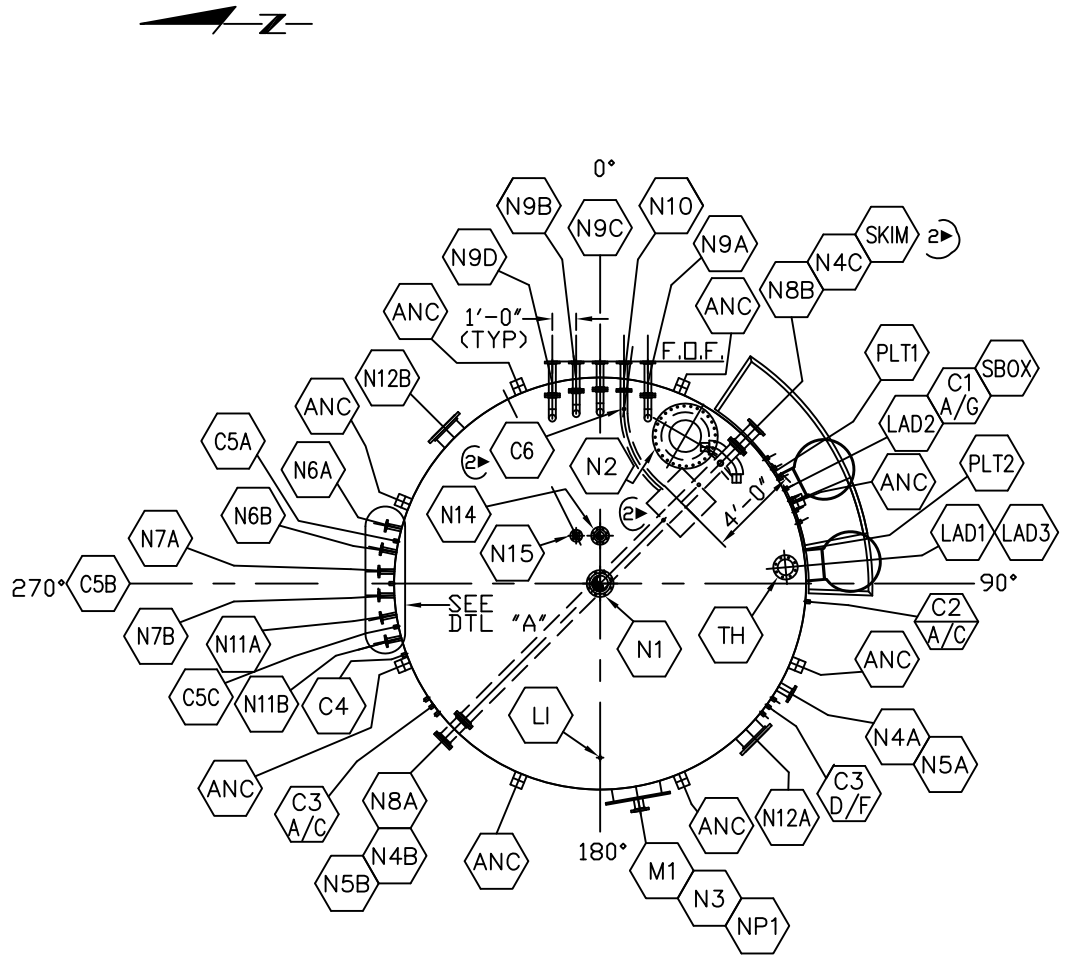

ORIENTATION

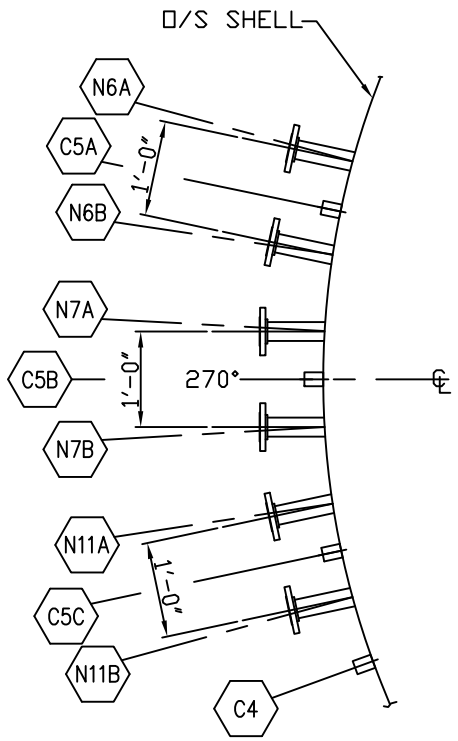

DETAIL "A"

G.L.M. Tanks & Equipment Ltd.
AN ITEQ STORAGE SYSTEMS COMPANY

ENGINEERING: NISKU	FABRICATION: NISKU			
PROJECT ENG. APPROVAL & DATE:	1► 05/26/99	REV'D AS PER CUSTOMER MARK UPS REC'D ON 05/20/99	JD	
	2► 06/08/99	REV'D AS SHOWN	JD	
CHECKED BY & DATE:				
DRAWN BY & DATE: J. OVELSON MAY 12, 1999	NO.	DATE	REVISION	BY CHK'D

TOLERANCES:
API-650 9th EDITION

DESCRIPTION:
GENERAL PLAN
CANADIAN CRUDE SEPARATORS
17'-3" O.D. x 48'-0" HG
PROCESS TANK
DRAYTON VALLEY, AB

CRN # / NATL BD #
N/A

PURCHASE ORDER #
811

SCALE: N.T.S.

DRAWING NUMBER J-99-088-1-3

REV. 2

THIS DRAWING IS THE PROPERTY OF ITEQ STORAGE SYSTEMS AND IS TO BE USED ONLY IN CONNECTION WITH WORK PERFORMED BY ITEQ STORAGE SYSTEMS. THE DRAWING IS NOT TO BE COPIED IN WHOLE OR IN PART AND MUST BE RETURNED UPON REQUEST.